IREDELL COUNTY HEALTH DEPARTMENT

Statesville Office (704) 878-5305 Mooresville Office (704) 660-3625 PERMIT # _

IMPROVEMENT PERMIT / AUTHORIZATION TO CONSTRUCT / OPERATION PERMIT / EXISTING SYSTEM

PIN # 4646-23-8511 Permit # 179832

APPLICANT: DEBORAH REID APPLICANT ADDRESS: 126 CONTINENTAL DR. - Mocksville

SITE ADDRESS: SAME PHONE: 845-548-4477 ALT. PHONE:

SITE DIRECTIONS: WILLIAMSON, PONDEROSA, CONTINENTAL, ON R

SUBDIVISION: LKN BONANZA SECTION: — LOT # 92 LOT AREA: .55 AC DESIGN FLOW: 360 L.T.A.R.: .3

Septic Tank Ex. 1000 (gal) STB Date

Pump Tank (gal) PT Date

Pump Make Model Serial #

Nitrification Fields 1 # Lines 3@60' Linear Ft: 180'

Trench Width 36" Max. Trench Bottom Depth 36" Gravel Depth

☐ New System ☐ Repair ☐ Expansion System Type: I II (III) IV V VI

System Description: 25% REDUCTION

Repair System Description: PANEL

Maintenance Agreement Required: ☐ YES ☒ NO

☒ GRAVITY ☐ PRESSURE

☐ Residence No. Bedrooms 3

☐ Business No. Persons

☒ Other No. Employees

☒ Slab ☐ Crawl Space


☐ Basement w/plumbing ☐ Basement w/o plumbing

Water Supply: ☒ Private ☐ Public ☐ Community

Comments / Conditions: Installed Quick 4 as shown Verified setback to well.

POOL

INITIAL SITE SKETCH

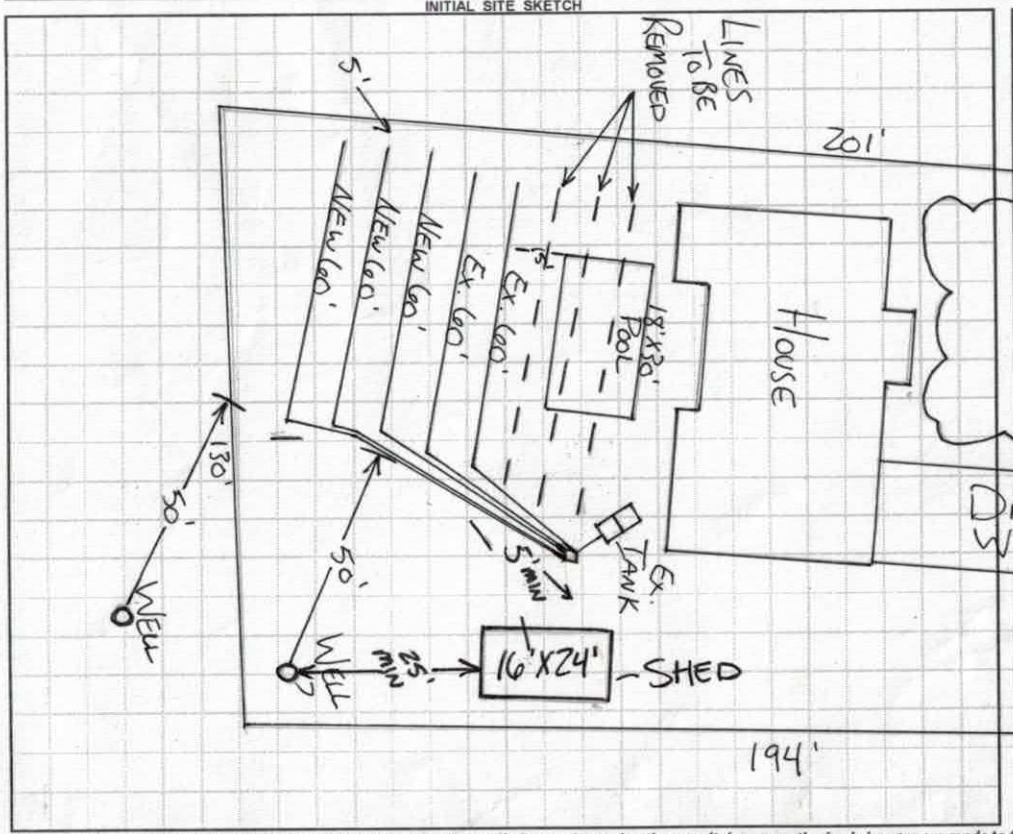

AS BUILT SKETCH

1"=40'

REMOVE TOP 3 LINES
ADD 3 NEW LINES AS SHOWN
BE SURE TO CHECK WELL
SET BACK BEFORE INSTALLATION

The proposed / existing SHED addition does not appear to impact the existing septic system.

**NOTE: BA 00-9 R.S.

Permit #170919 Date: 7-24-13

ICHD-Environmental Health Division

Permit can be suspended or revoked if any false information is supplied toward securing the permit / any unauthorized changes are made to the site / any unauthorized changes are made in the installation of the system. **CONTACT A LOCATOR SERVICE PRIOR TO ANY EXCAVATION**

☐ **IMPROVEMENT PERMIT** *with plat valid without expiration.* ☐ **IMPROVEMENT PERMIT** *with site plan valid for 60 mos.* ☒ **AUTHORIZATION TO CONSTRUCT** *valid for period equal to IMPROVEMENT PERMIT--not to exceed 60 mo.*

Owner / Applicant Signature: Deborah Reid Date: 7-18-13 Installed by: A-1 Backhoe

IMPROVEMENT PERMIT by: BA Ellis Date: 7-16-13 OPERATION PERMIT by: Marie H. Dotson RS Date: 8/29/13

AUTHORIZATION TO CONSTRUCT by: BA Ellis Date: 7-16-13 Existing System Inspected by: Date:

Health Dept. Copy - WHITE Applicant (Final Approval) - YELLOW Applicant (Conditional Approval) - PINK