IREDELL COUNTY HEALTH DEPARTMENT

STATESVILLE 704-878-5305 MOORESVILLE 704-664-5281

IMPROVEMENT PERMIT / AUTHORIZATION TO CONSTRUCT / OPERATION PERMIT / EXISTING SYSTEM INSPECTION

PERMIT# Repair PIN# 4646239994

OWNER OR CONTRACTOR Ricky Hartline DATE 12/8/04

ADDRESS 267 Ponderosa Cir Mooresville NC 28117 PHONE: Business _____ Home 704 663 5454

LOCATION Williamson, To Ponderosa, on Lt, Just Before ~~Cont~~. Continental Ln #267

SUBDIVISION _____ BLOCK / SECTION _____ LOT _____ LOT AREA _____ SITE CLASS. PS DESIGN FLOW 360 L.T.A.R. _____

Septic Tank: ~~Existing~~ Gallons: CCB 1012 Date _____

Pump Tank: New Gallons: PT _____ Date _____

Pump Make: _____ Model _____ Serial No. _____

Nitrification Field: No Fields 1 Square Feet 720 Linear Feet 240'

No Lines 4@60' Trench Width 36" Max Trench Bottom Depth 36" Gravel Depth 18"

☐ New System ☒ Repair System Type: I, II, III, IV, V, VI

System Description: _____

Repair System Description: Conventional / Bull Run

Maintenance Agreement Required: ☐ Yes ☒ No

☒ House/Mod. Home No. Bedrooms 3

☐ Mobile Home No. Bathrooms _____

☐ Business No. Employees _____

☐ Other _____

☒ Slab ☒ Crawl Space ☐ Basement w/plumbing ☐ Basement wo/plumbing


Water Supply: ☒ Individual ☐ Public ☐ Community

Comments:/Conditions:


NOT to scale

Comments:/Conditions:

INITIAL SITE SKETCH

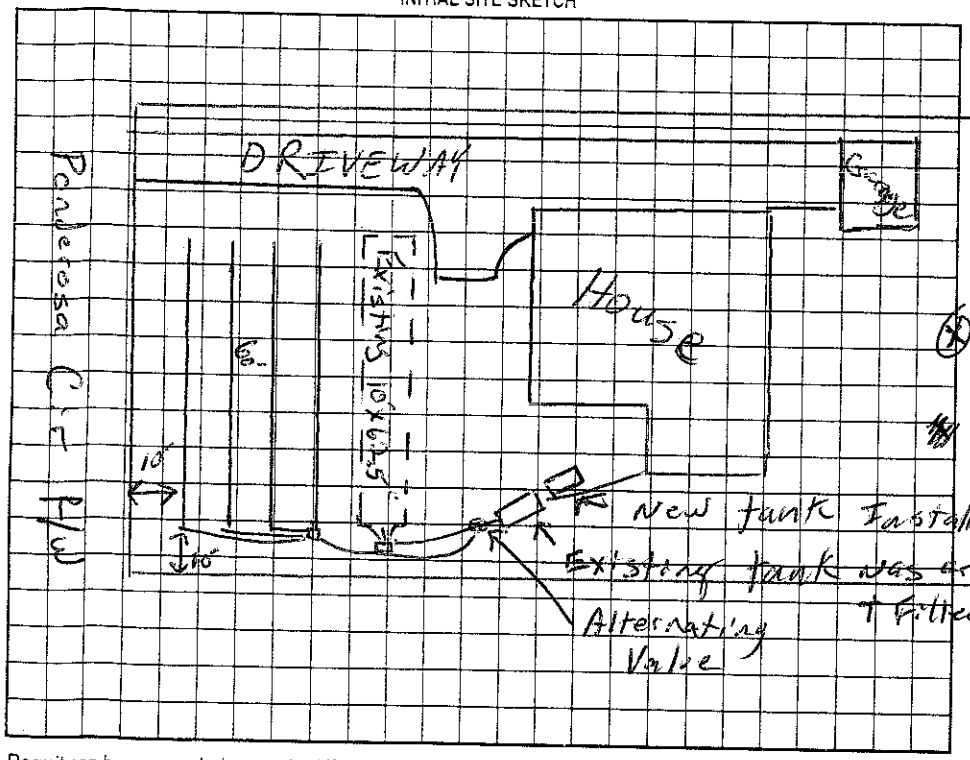

AS BUILT SKETCH

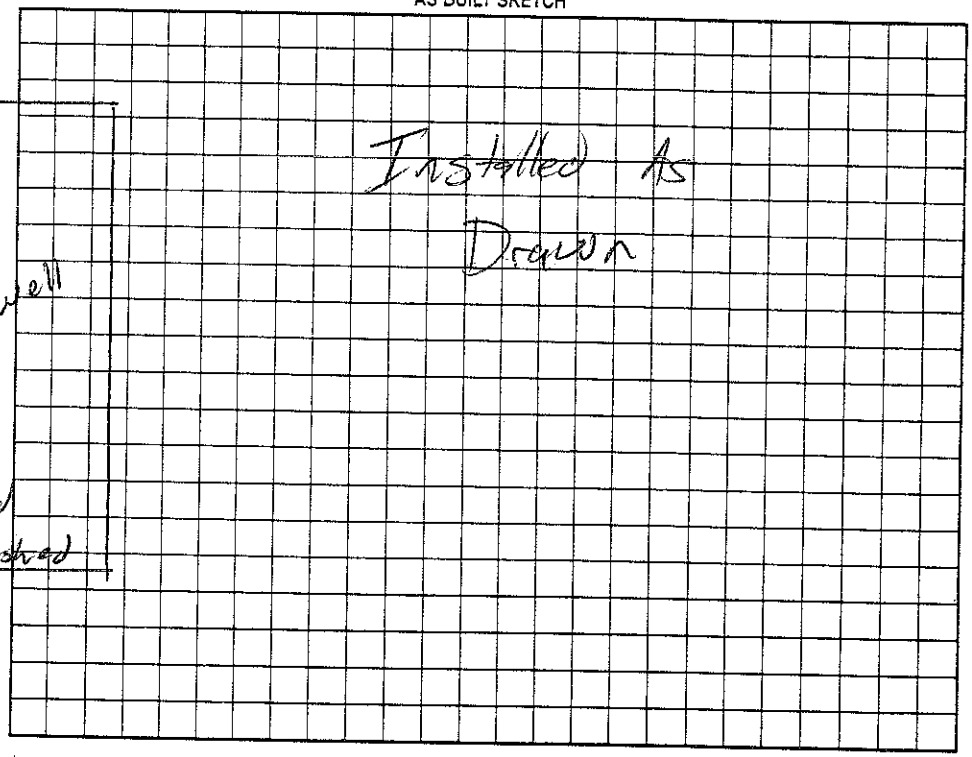

Permit can be suspended or revoked if any false information is supplied toward securing the permit/any unauthorized changes are made to the site/any unauthorized changes are made in the installation of the system. Improvement Permit with plat valid without expiration. Improvement Permit with site plan valid for sixty months. Authorization to Construct is valid for a period equal to that of Improvement Permit – not to exceed sixty months.

Signed: _____ date _____

Improvement Permit by: RS date 12/8/04

Authorization to Construct by: RS date 12/8/04

Installed by: Lantz Wastewater Mgmt.

Operation Permit by: RS date 1/4/05

Existing System Inspection by: _____ date _____

HEALTH DEPT. COPY: WHITE OWNER COPY (FINAL): YELLOW OWNER COPY (INITIAL): PINK