IREDELL COUNTY HEALTH DEPARTMENT

STATESVILLE 704-878-5305 280.00 MOORESVILLE 704-664-5281

IMPROVEMENT PERMIT / AUTHORIZATION TO CONSTRUCT / OPERATION PERMIT / EXISTING SYSTEM INSPECTION

PERMIT# ~~H7413~~ / 28853 PIN# 4646-24-4179 DATE 12/31/05

OWNER OR CONTRACTOR Mark Davis PHONE: Business 704 651-3920 Home

ADDRESS 13707 Shiella Caruth Dr. Huntersville NC 28078

LOCATION Williamson Rd, TR Ponderosa Cir. On Lt, #28.

SUBDIVISION Bonanza BLOCK / SECTION LOT 68/69 LOT AREA 1.01 AC SITE CLASS. PS DESIGN FLOW 450 L.T.A.R. 0.3

Septic Tank: Existing Gallons: STB Date

Pump Tank: Gallons: PT Date

Pump Make: Model Serial No.

Nitrification Field: No Fields 1 Square Feet 525 Add. Linear Feet 175' Add.

No Lines 2 Trench Width 36" Max Trench Bottom Depth 36" Gravel Depth —

☐ New System ☐ Repair System Type: I, II, (III), IV, V, VI

System Description: Addition 25% Reduct.

Repair System Description: LP Panel Block

Maintenance Agreement Required: ☐ Yes ☒ No

☒ House/Mod. Home No. Bedrooms 4

☐ Mobile Home No. Bathrooms

☐ Business No. Employees

☐ Other

☐ Slab ☐ Crawl Space ☒ Basement w/plumbing ☐ Basement wo/plumbing


Water Supply: ☒ Individual ☐ Public ☐ Community Existing

Comments/Conditions: 300' of Existing Conventional = 900 ft²
Adding 175' of 25% Reduction = 700 ft²
1600 ft²


Comments/Conditions:

1"=50'

INITIAL SITE SKETCH

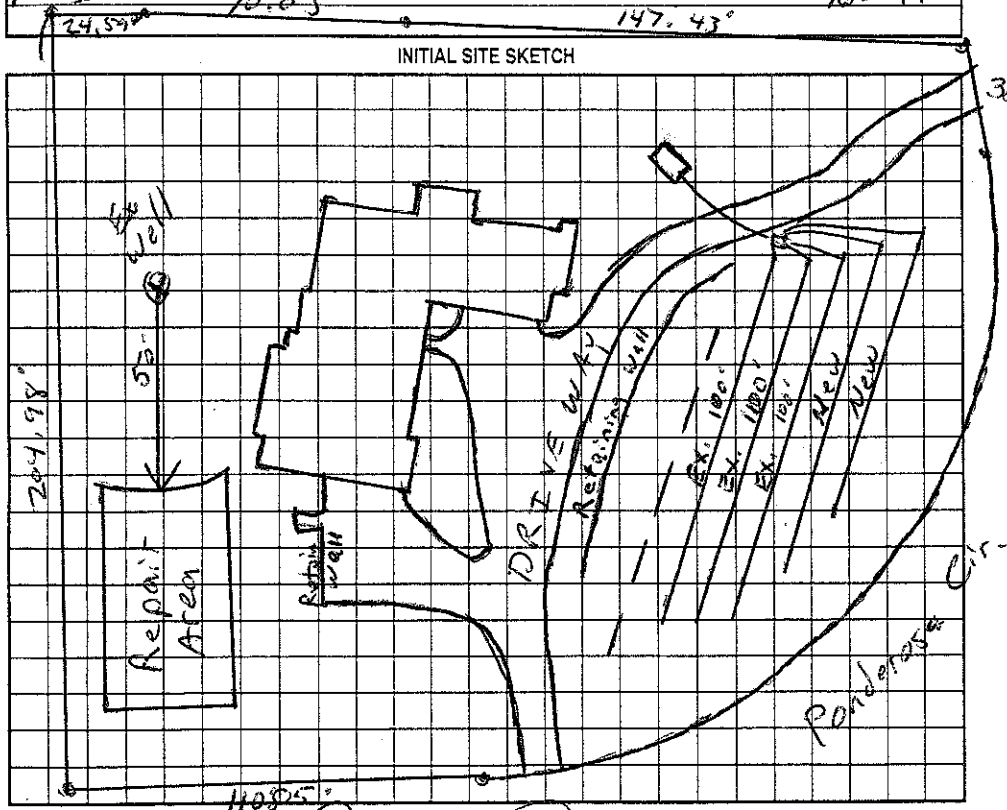

AS BUILT SKETCH

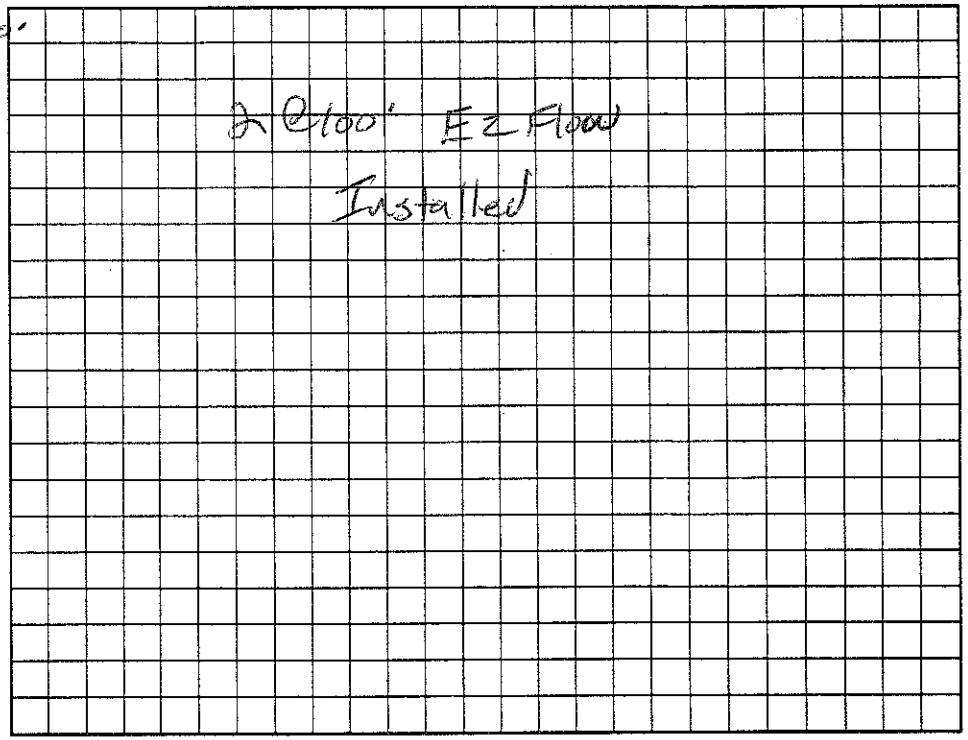

Permit can be suspended or revoked if any false information is supplied toward securing the permit/any unauthorized changes are made to the site/any unauthorized changes are made in the installation of the system. Improvement Permit with plat valid without expiration. Improvement Permit with site plan valid for sixty months. Authorization to Construct is valid for a period equal to that of Improvement Permit – not to exceed sixty months.

Signed: Mark Davis date 1-5-03 Installed by: Reid Ensley

Improvement Permit by: RS date 12/31/03 Operation Permit by: RS date 9/15/05

Authorization to Construct by: RS date 12/31/05 Existing System Inspection by: date

HEALTH DEPT. COPY: WHITE OWNER COPY (FINAL): YELLOW OWNER COPY (INITIAL): PINK