IREDELL COUNTY HEALTH DEPARTMENT

Statesville Office (704) 878-5305 Mooresville Office (704) 660-3625 PERMIT # 213018

IMPROVEMENT PERMIT / AUTHORIZATION TO CONSTRUCT / OPERATION PERMIT / EXISTING SYSTEM

PIN # 4646261849

APPLICANT: Keri Johnson/Fixie Chicks Prop. APPLICANT ADDRESS: 165 Jacobs Woods Troutman, NC

SITE ADDRESS: 384 Sundown Rd. Mooresville, NC 28117 PHONE: 704 235-8455 ALT. PHONE:

SITE DIRECTIONS: Brawley School Rd TL ~~Sundown~~ Williamson Rd TR Sundown Rd on right #384

SUBDIVISION: Mary Knox Atwell SECTION: — LOT # 1 LOT AREA: DESIGN FLOW: 360gpd L.T.A.R.: 4

Septic Tank 1000 J (gal) STB Date
Pump Tank (gal) PT Date
Pump Make Model Serial #
Nitrification Fields 1 # Lines 3 Linear Ft: 300'
Trench Width 36" Max. Trench Bottom Depth — Gravel Depth 12"

☐ New System ☒ Repair ☐ Expansion System Type: I (II) III IV V VI
System Description: Existing Gravity - Conventional
Repair System Description: Modified Conventional
Maintenance Agreement Required: ☐ YES ☒ NO
☒ GRAVITY ☐ PRESSURE


☒ Residence No. Bedrooms 3
☐ Business No. Persons
☐ Other No. Employees
☐ Slab ☒ Crawl Space
☐ Basement w/plumbing ☐ Basement w/o plumbing

Water Supply: ☐ Private ☐ Public ☐ Community


Comments / Conditions:

The proposed deck does not appear to impact the existing Septic System.
★ Must keep deck "footers" at least 5ft from the Septic System.

INITIAL SITE SKETCH

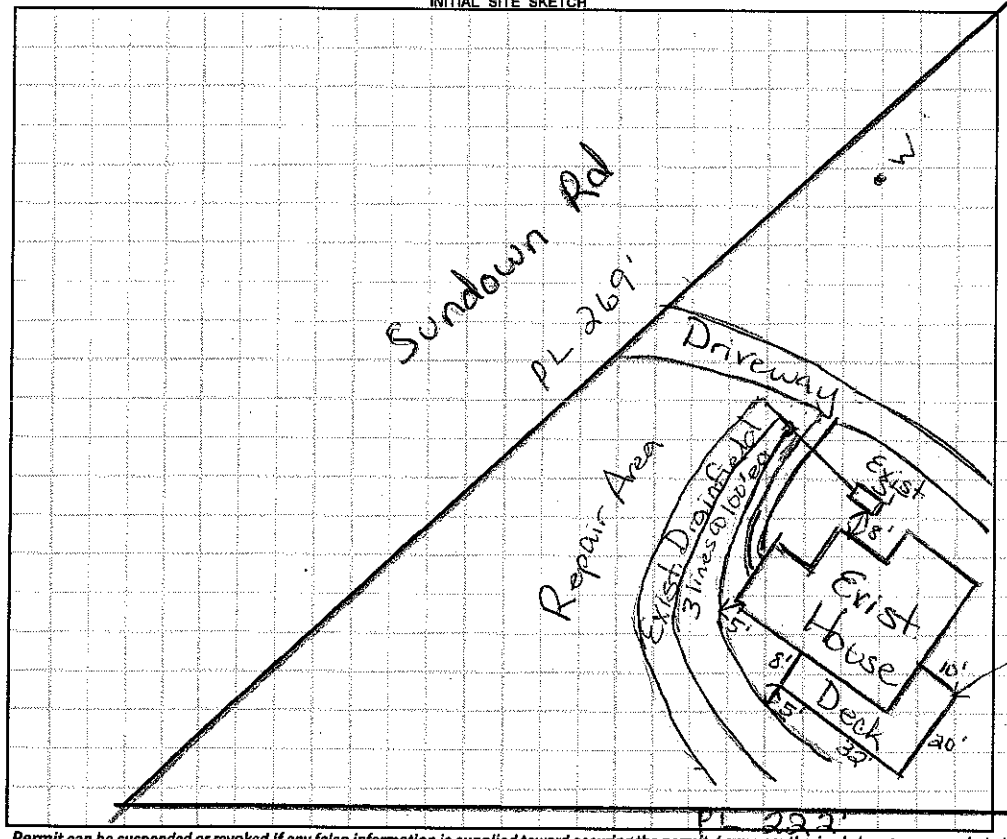

AS BUILT SKETCH

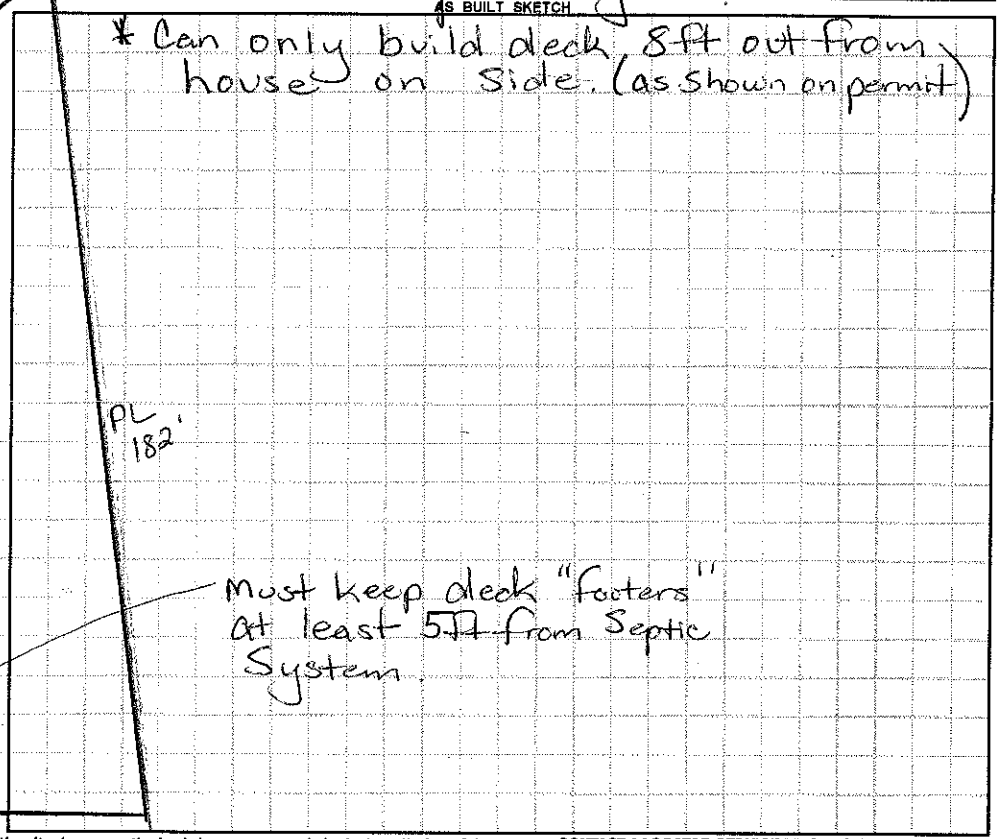

Permit can be suspended or revoked if any false information is supplied toward securing the permit / any unauthorized changes are made to the site / any unauthorized changes are made in the installation of the system. **CONTACT A LOCATOR SERVICE PRIOR TO ANY EXCAVATION**

☐ **IMPROVEMENT PERMIT *with plat*** *valid without expiration.* ☐ **IMPROVEMENT PERMIT *with site plan*** *valid for 60 mos.* ☐ **AUTHORIZATION TO CONSTRUCT** *valid for period equal to IMPROVEMENT PERMIT--not to exceed 60 mo.*

Owner / Applicant Signature: Keri Johnson Date: 10-13-15 Installed by:

IMPROVEMENT PERMIT by: Date: OPERATION PERMIT by: Date:

AUTHORIZATION TO CONSTRUCT by: Date: Existing System Inspected by: Maria H. Gibson RS Date: 10/12/15

Health Dept. Copy - WHITE Applicant (Final Approval) - YELLOW Applicant (Conditional Approval) - PINK