2 of

IREDELL COUNTY HEALTH DEPARTMENT

STATESVILLE 704-878-5305 MOORESVILLE 704-664-5281

IMPROVEMENT PERMIT / CERTIFICATE OF COMPLETION / OPERATION PERMIT / EXISTING SYSTEM INSPECTION

PROPERTY DESCRIPTION NO. 20675 DATE 5/24/95 TAX MAP NO. 2K - B - 27 Pt of Watershed: [X] Yes [ ] No

OWNER OR CONTRACTOR Genesis Development LTD. PHONE: Business 478-2952 ~~Home~~ 4646-26-3786

ADDRESS PO Box 44 Sherrills Ford, NC. 28636

LOCATION Sundown Rd TR Shoreview Drive TL Junheavenct to 4th lot on (R)

SUBDIVISION LAKE VISTA BLOCK / SECTION 1 LOT 14 LOT AREA ~.91 AC SITE CLASS. P DESIGN FLOW 480 L.T.A.R. .3

Septic Tank: 1000 Gallons; STB 794 Date 7/9/97

Pump Tank: _____ Gallons; PT _____ Date _____

Pump Make: _____ Model _____ Serial No. _____

Nitrification Field: No Fields 1 Square Feet 1600 Linear Feet *400 (533)

No Lines 5 Trench Width 36" Max Trench Bottom Depth 31" Gravel Depth N/A

[X] New System [ ] Repair System Type: I, II, (III) IV, V, VI

System Description: GRAV - INFILTRATOR

Repair System Description: GRAV - PANEL

Maintenance Agreement Required: [ ] Yes [ ] No

[X] House/Mod. Home No. Bedrooms 4

[ ] Mobile Home No. Bathrooms 3

[ ] Business No. Employees ____

[ ] Other _____


[ ] Slab [X] Crawl Space [ ] Basement w/plumbing [ ] Basement wo/plumbing

Water Supply: [X] Individual [ ] Community [ ] Public


Comments: * 25% reduction for use of Infiltrator System

Comments:

INITIAL SITE SKETCH

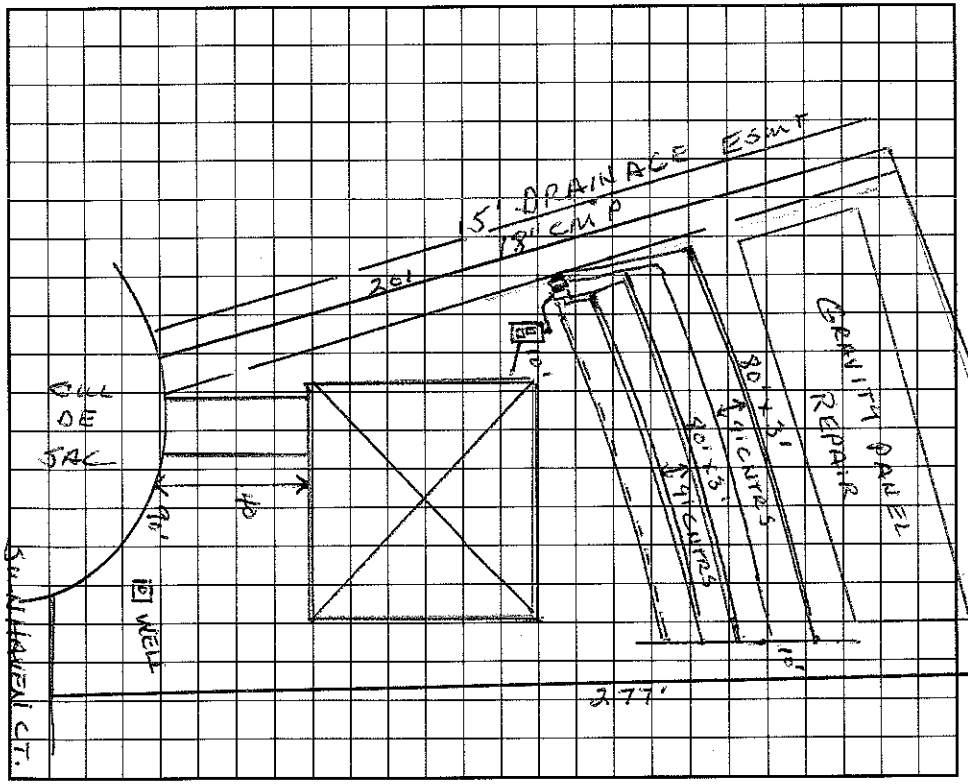

AS BUILT SKETCH

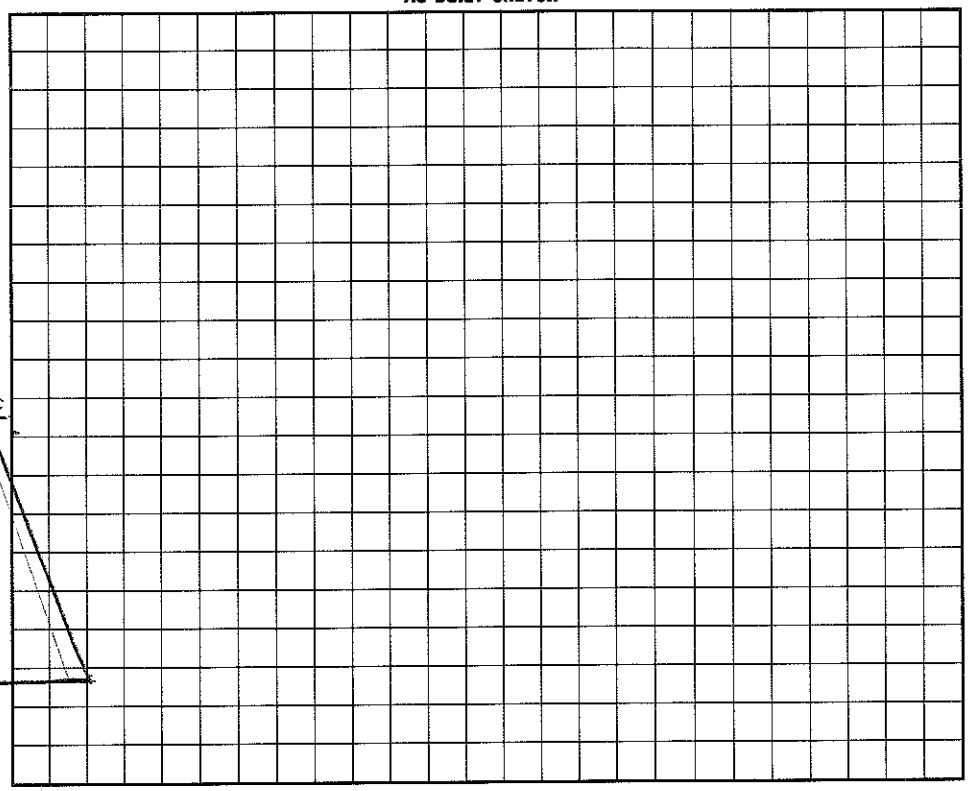

I understand that this permit can be suspended or revoked if any false information is supplied toward securing the permit/any unauthorized changes are made to the site/any unauthorized changes are made in the installation of the system. Improvement Permit is valid for ~~60~~ months from date of issuance.

Signed: Ted G. Young Jr.

Improvement Permit by: Wesley Sparks RS. date 5/24/95

Existing System Inspection by: _____ date _____

Installed by: Iron Horse Grading

Certificate of Completion by: Wesley Sparks RS. date 7/2/97

Operation Permit by: Wesley Sparks RS. date 7/2/97

HEALTH DEPT. COPY: WHITE INSPECTION COPY (FINAL): GREEN OWNER COPY (FINAL): YELLOW INSPECTION COPY (INITIAL): PINK OWNER COPY (INITIAL): GOLD