IREDELL COUNTY HEALTH DEPARTMENT

STATESVILLE 704-878-5305 MOORESVILLE 704-664-5281

IMPROVEMENT PERMIT / AUTHORIZATION TO CONSTRUCT / OPERATION PERMIT / EXISTING SYSTEM INSPECTION

2:30

PERMIT# 139863 PIN# 4646263877 DATE 1-4-07

OWNER OR APPLICANT CHARLES ALEXANDER PHONE: Business (OWNER) Home 704-799-1309 704 988 2924

ADDRESS 116 SUNHAVEN LN

LOCATION Crawley sch Rd TL Williamson TR Sundown TR Shoreview TL Sunhaven on right

SUBDIVISION Lake Vista BLOCK / SECTION LOT 13 LOT AREA .668 Ac SITE CLASS. PS DESIGN FLOW 480gpd L.T.A.R. .3 gpd/ft²

Septic Tank: 1000 Gallons; STB 825 Date 8-1-07
Pump Tank: Gallons; PT Date
Pump Make: Model Serial No.
Nitrification Field: No Fields 1 Square Feet 1600 Linear Feet 400
No Lines 5@80' Trench Width 36" Max Trench Bottom Depth 36" Gravel Depth NA

☒ New System ☐ Repair ☐ Expansion System Type: I (II) III IV V VI
System Description: 2590 reduction gravity
Repair System Description: LP PPBPS
Maintenance Agreement Required: ☐ Yes ☒ No

☒ House/Mod. Home ☐ Mobile Home ☐ Business ☐ Other
No. Bedrooms 4 No. Persons 8 No. Employees

Water Supply: ☒ Individual ☐ Public ☐ Community


☒ Gravity ☐ Pressure ☐ Slab ☒ Crawl Space ☐ Basement w/plumbing ☐ Basement wo/plumbing

Comments/Conditions: Flow splitter such as zoeller or may use endcap distribution if infiltrator used


Comments/Conditions: Installed Quick 4 as shown.

1"=50'

INITIAL SITE SKETCH

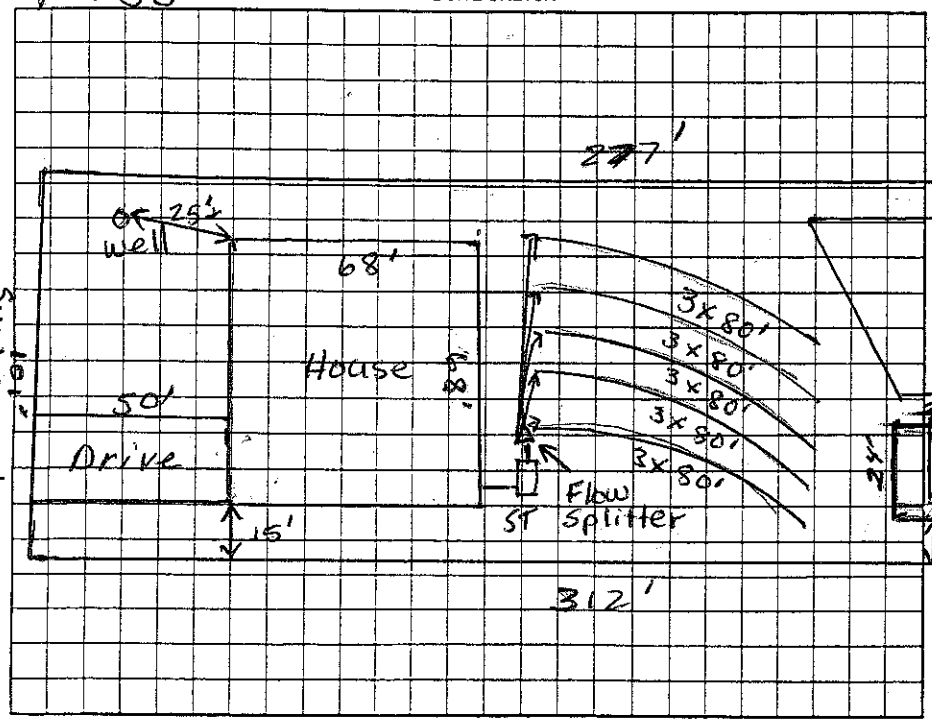

AS BUILT SKETCH

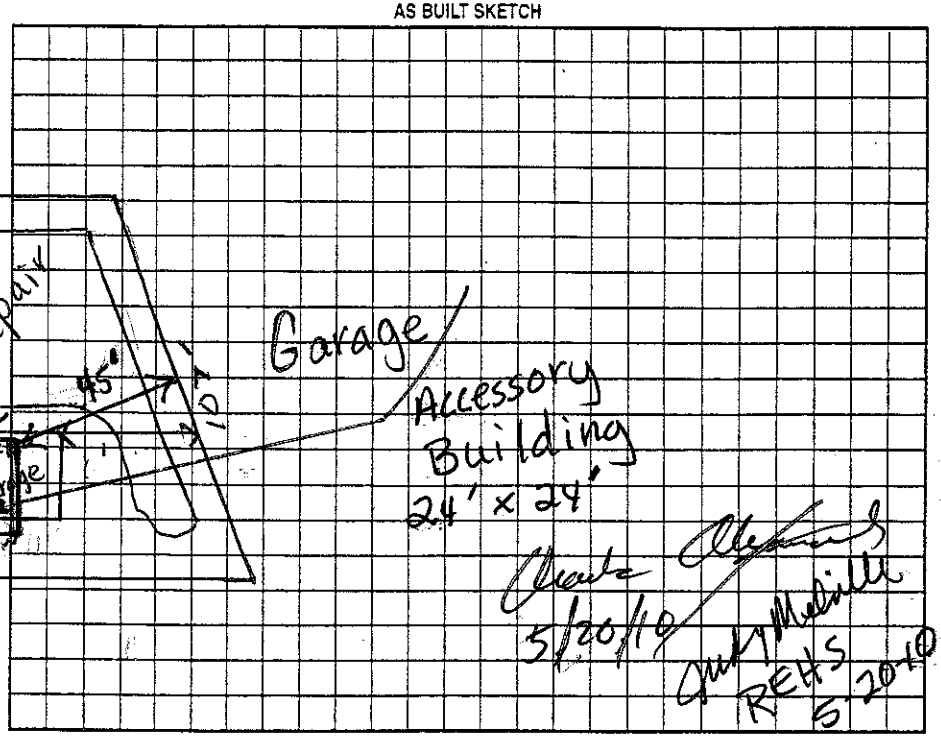

Permit can be suspended or revoked if any false information is supplied toward securing the permit/any unauthorized changes are made to the site/any unauthorized changes are made in the installation of the system. Improvement Permit with plat valid without expiration ☐ Improvement Permit with site plan valid for sixty months ☒ Authorization to Construct is valid for a period equal to that of Improvement Permit - not to exceed sixty months.

Signed: Lori a Yaya date 1-5-07

Improvement Permit by: Judy Melville date 1-4-07

Authorization to Construct by: Wesley Sparks R.S. date 3/7/07

Installed by: Rowan Septic date 9/18/07

Operation Permit by: Marvin Dotson date

Existing System Inspection by: date

HEALTH DEPT. COPY: WHITE OWNER COPY (FINAL): YELLOW OWNER COPY (INITIAL): PINK