IREDELL COUNTY HEALTH DEPARTMENT

STATESVILLE 704-878-5305 MOORESVILLE 704-664-5281

IMPROVEMENT PERMIT / CERTIFICATE OF COMPLETION / OPERATION PERMIT / EXISTING SYSTEM INSPECTION

PROPERTY DESCRIPTION NO. 20670 DATE 5/24/95 TAX MAP NO. 2K B 27 Pt of Watershed: [X] Yes [ ] No

OWNER OR CONTRACTOR Genesis Developers LTD. PHONE: Business 478-2952 Home 464-26-3977

ADDRESS PO Box 44 Sherrills Ford NC. 28673

LOCATION (R) Shoreview Dr. off Sundown Rd, (L) on Sunhaven Ct. to 2ND lot on (R)

SUBDIVISION LAKE VISTA BLOCK / SECTION 1 LOT 12 LOT AREA ~.89 AC SITE CLASS. P DESIGN FLOW 480 L.T.A.R. .3

Septic Tank: 1000 Gallons; STB 794 Date 12/12/94

Pump Tank: _____ Gallons; PT _____ Date _____

Pump Make: _____ Model _____ Serial No. 412

Nitrification Field: No Fields 1 Square Feet 1600 Linear Feet ~~533~~

No Lines 6 Trench Width 36" Max Trench Bottom Depth 34" Gravel Depth N/A

[X] New System [ ] Repair System Type: I, II, (III) IV, V, VI

System Description: Gravel - Sinfiltrator

Repair System Description: None

Maintenance Agreement Required: [ ] Yes [X] No

[X] House/Mod. Home No. Bedrooms 4

[ ] Mobile Home No. Bathrooms 3

[ ] Business No. Employees _____

[ ] Other _____


[ ] Slab [X] Crawl Space [ ] Basement w/plumbing [ ] Basement wo/plumbing

Water Supply: [X] Individual [ ] Community [ ] Public


Comments: X 25% reduction for Sinfiltrator use

Comments (6-68' x 3')

INITIAL SITE SKETCH

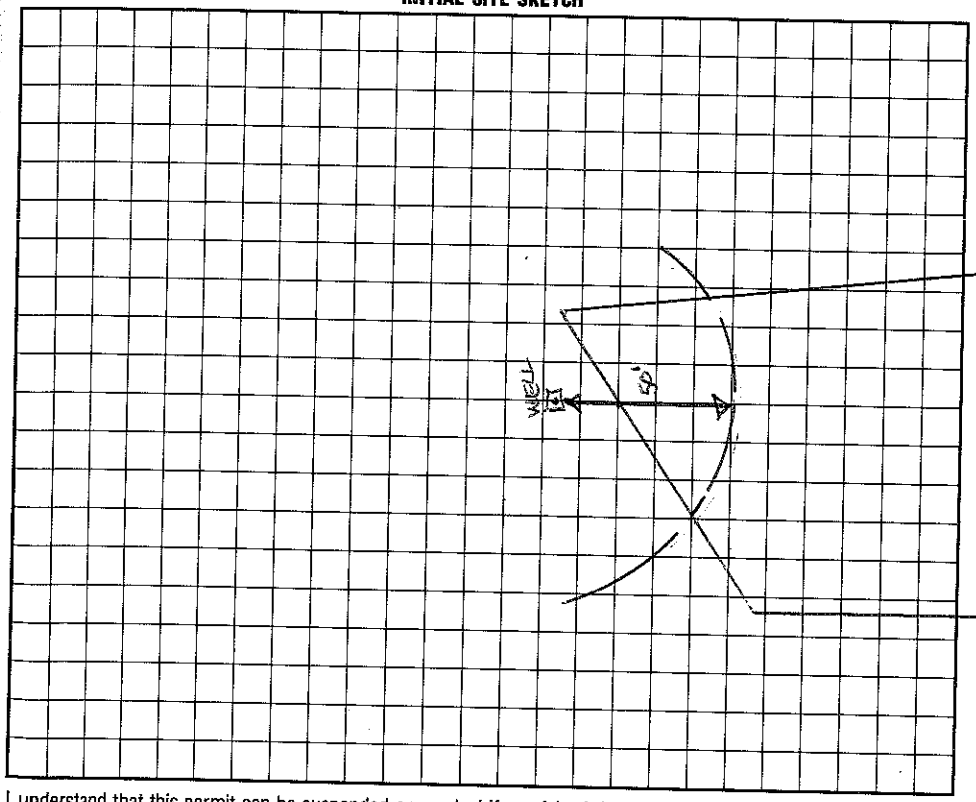

AS BUILT SKETCH

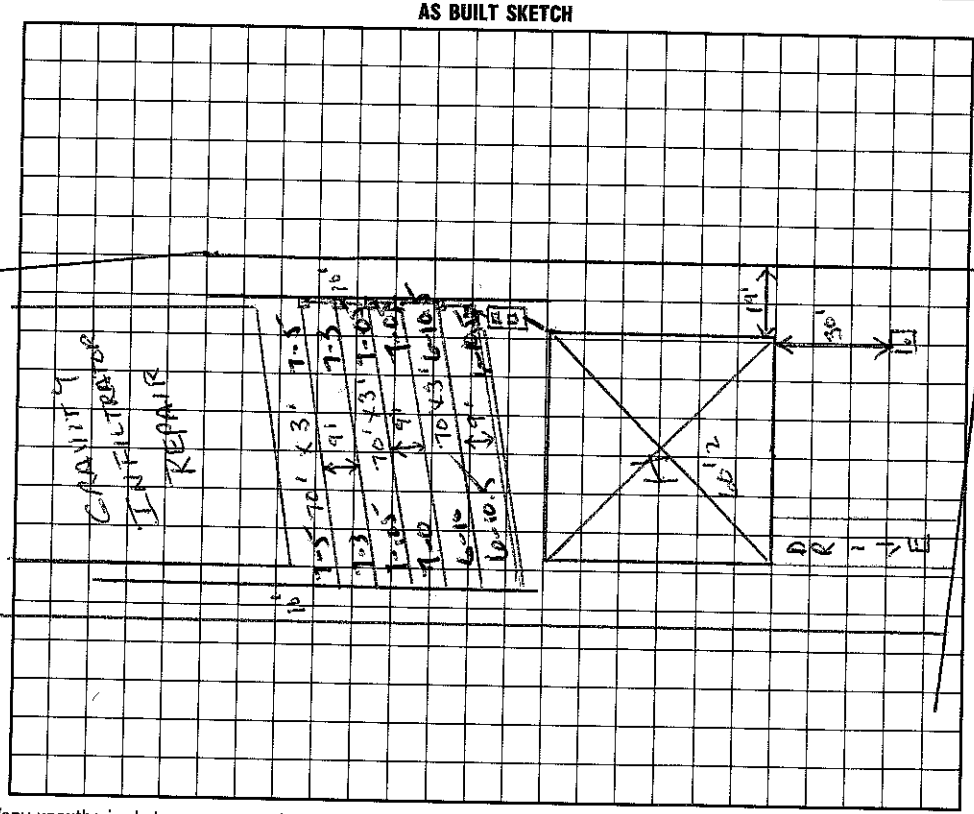

I understand that this permit can be suspended or revoked if any false information is supplied toward securing the permit/any unauthorized changes are made to the site/any unauthorized changes are made in the installation of the system. Improvement Permit is valid for 60 months from date of issuance.

Signed: _____

Improvement Permit by: Wesley Sparks R.S. date 5/24/95

Existing System Inspection by: Wesley Sparks date 2/19/98

Installed by: MacLeod Const.

Certificate of Completion by: Wesley Sparks R.S. date 2/20/98

Operation Permit by: Wesley Sparks R.S. date 2/20/98

HEALTH DEPT. COPY: WHITE INSPECTION COPY (FINAL): GREEN OWNER COPY (FINAL): YELLOW INSPECTION COPY (INITIAL): PINK OWNER COPY (INITIAL): GOLD