IREDELL COUNTY HEALTH DEPARTMENT

STATESVILLE 704-878-5305 Ø MOORESVILLE 704-664-5281

IMPROVEMENT PERMIT / AUTHORIZATION TO CONSTRUCT / OPERATION PERMIT / EXISTING SYSTEM INSPECTION

PERMIT# 114826 PIN# 4646-26-4358 DATE 9/14/04

OWNER OR CONTRACTOR Burton Gell Man PHONE: Business 704-650-1900 Home 704-664-2252

ADDRESS 131 - Sunhaven Ln Mooresville NC 28117 Site: 336 Sundown Rd

LOCATION Williamson, TR Sundown, On Rt #336 Sundown Rd

SUBDIVISION _____ BLOCK / SECTION _____ LOT _____ LOT AREA ≈1.1 AC SITE CLASS. PS DESIGN FLOW 480 L.T.A.R. —

Septic Tank: Exist. Gallons; STB _____ Date _____

Pump Tank: _____ Gallons; PT _____ Date _____

Pump Make: _____ Model _____ Serial No. _____

Nitrification Field: No Fields ____ Square Feet _____ Linear Feet [redacted]

No Lines _____ Trench Width [redacted] Max Trench Bottom Depth _____ Gravel Depth _____

☐ New System ☐ Repair System Type: (I) II III IV V VI

System Description: Exist. Conv. Bed

Repair System Description: _____

Maintenance Agreement Required: ☐ Yes ☒ No

☒ House/Mod. Home No. Bedrooms 4 Max

☐ Mobile Home No. Bathrooms ____

☐ Business No. Employees ____

☐ Other _____


☐ Slab ☒ Crawl Space ☐ Basement w/plumbing ☐ Basement wo/plumbing

☒ Water Supply:
☒ Individual
☐ Public
☐ Community
Existing


Comments:/Conditions:

Comments:/Conditions:

INITIAL SITE SKETCH

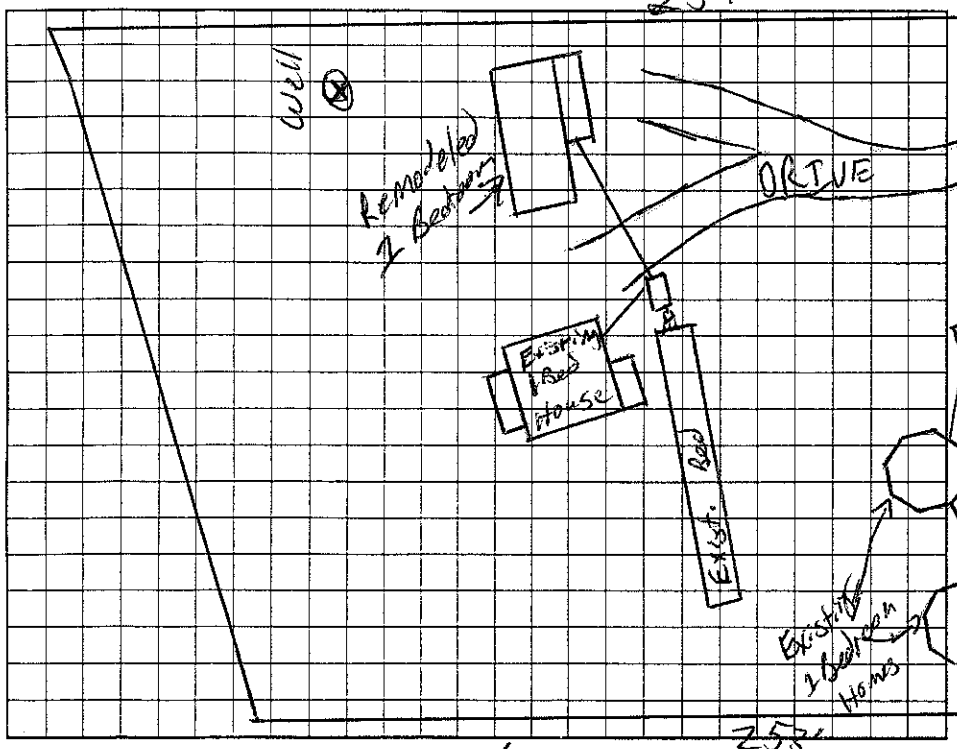

AS BUILT SKETCH

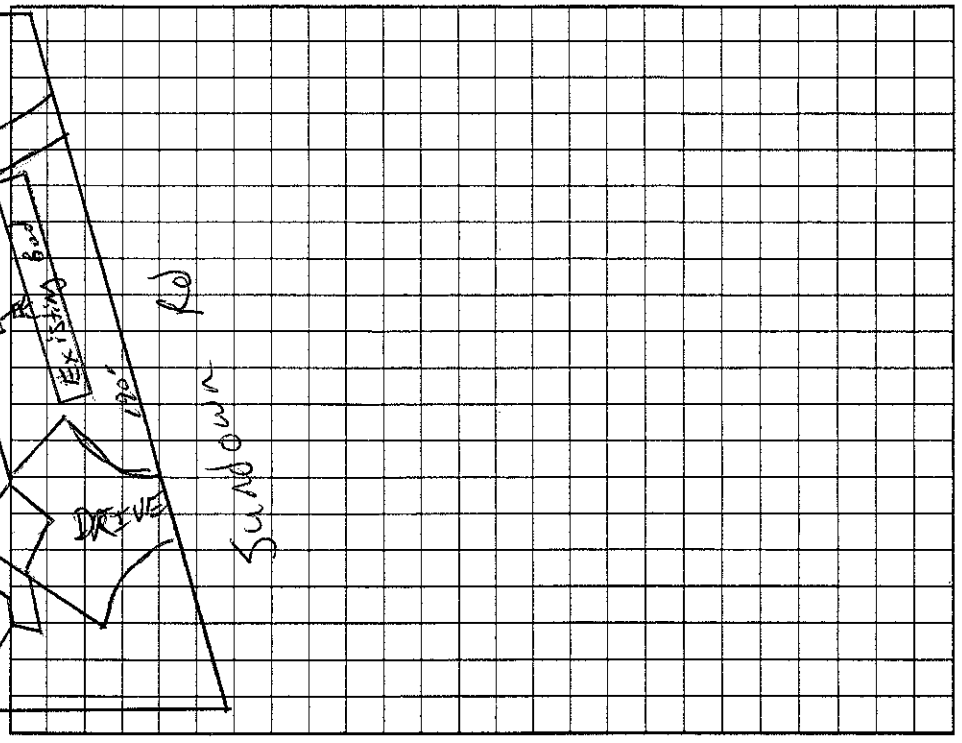

Permit can be suspended or revoked if any false information is supplied toward securing the permit/any unauthorized changes are made to the site/any unauthorized changes are made in the installation of the system. Improvement Permit with plat valid without expiration. Improvement Permit with site plan valid for sixty months. Authorization to Construct is valid for a period equal to that of Improvement Permit – not to exceed sixty months.

Signed: Burton A. Gell date 9/14/04 Installed by: _____

Improvement Permit by: _____ date _____ Operation Permit by: _____ date _____

Authorization to Construct by: _____ date _____ Existing System Inspection by: RS date 9/14/04

HEALTH DEPT. COPY: WHITE OWNER COPY (FINAL): YELLOW OWNER COPY (INITIAL): PINK