1,700

IREDELL COUNTY HEALTH DEPARTMENT

STATESVILLE 704-878-5305 MOORESVILLE 704-664-5281

IMPROVEMENT PERMIT / CERTIFICATE OF COMPLETION / OPERATION PERMIT / EXISTING SYSTEM INSPECTION

PROPERTY DESCRIPTION NO. 20677 DATE 9/18/97 TAX MAP NO. 2KB27 Pt of

OWNER OR CONTRACTOR George Allen PHONE: Business 1-800 979-6149 Home 483-6727

ADDRESS 7924 Shippy Ln Denver, NC 28037 4646-26-5650

LOCATION Williamson Rd TR Sundown Rd TL on Sunhaven Ct to Cul de sac lot to left of center

SUBDIVISION Lake Vista BLOCK / SECTION 1 LOT 16 LOT AREA ~1.18 Acre SITE CLASS. PS DESIGN FLOW 360 gpd L.T.A.R. .3

Watershed: ☒ Yes ☐ No

Septic Tank: 1000 Gallons; STB 1012 Date 10/21/97

Pump Tank: _____ Gallons; PT _____ Date _____

Pump Make: _____ Model _____ Serial No. _____

Nitrification Field: No Fields 1 Square Feet 900' Linear Feet 300'

No Lines 4 at 75' Trench Width 36" Max Trench Bottom Depth 31"

☒ New System ☐ Repair System Type: I, II, III, IV, V, VI

System Description: Gravel-Plastic Chamber across 18"

Repair System Description: Same

Maintenance Agreement Required: ☐ Yes ☒ No

Gravel Depth N/A

☒ House/Mod. Home No. Bedrooms 3

☐ Mobile Home No. Bathrooms 3

☐ Business No. Employees ____

☐ Other _____

☐ Slab ☒ Crawl Space ☐ Basement w/plumbing ☐ Basement wo/plumbing


Water Supply: ☒ Individual ☐ Community ☐ Public

Comments:


Comments:

Scale 1: 40'

INITIAL SITE SKETCH

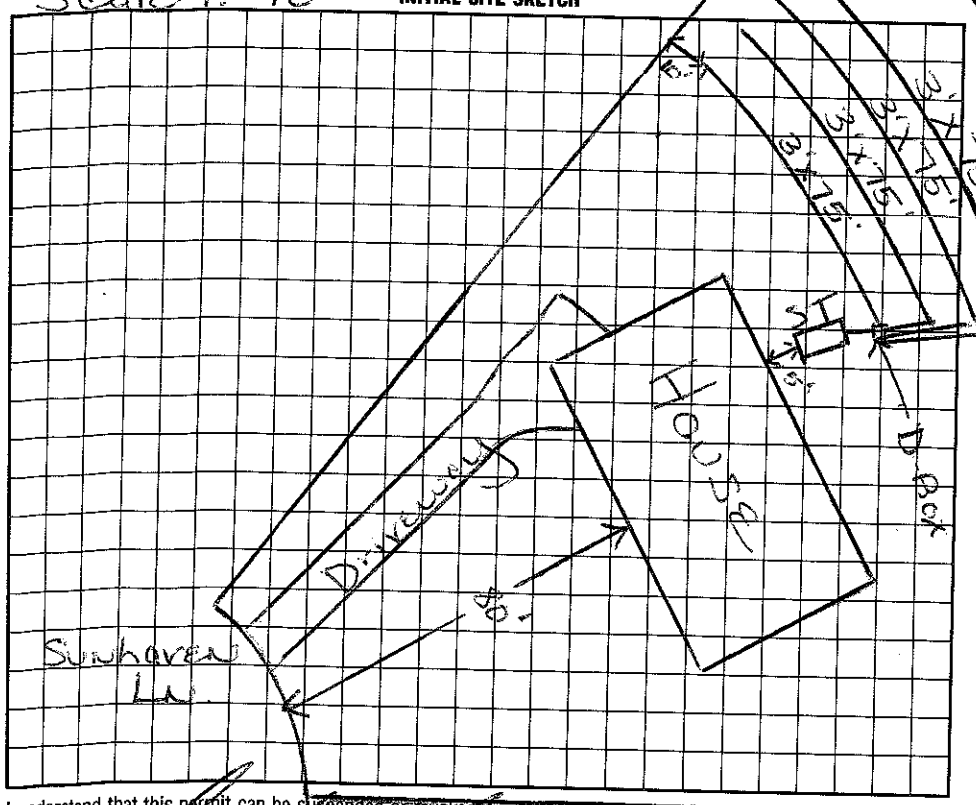

AS BUILT SKETCH

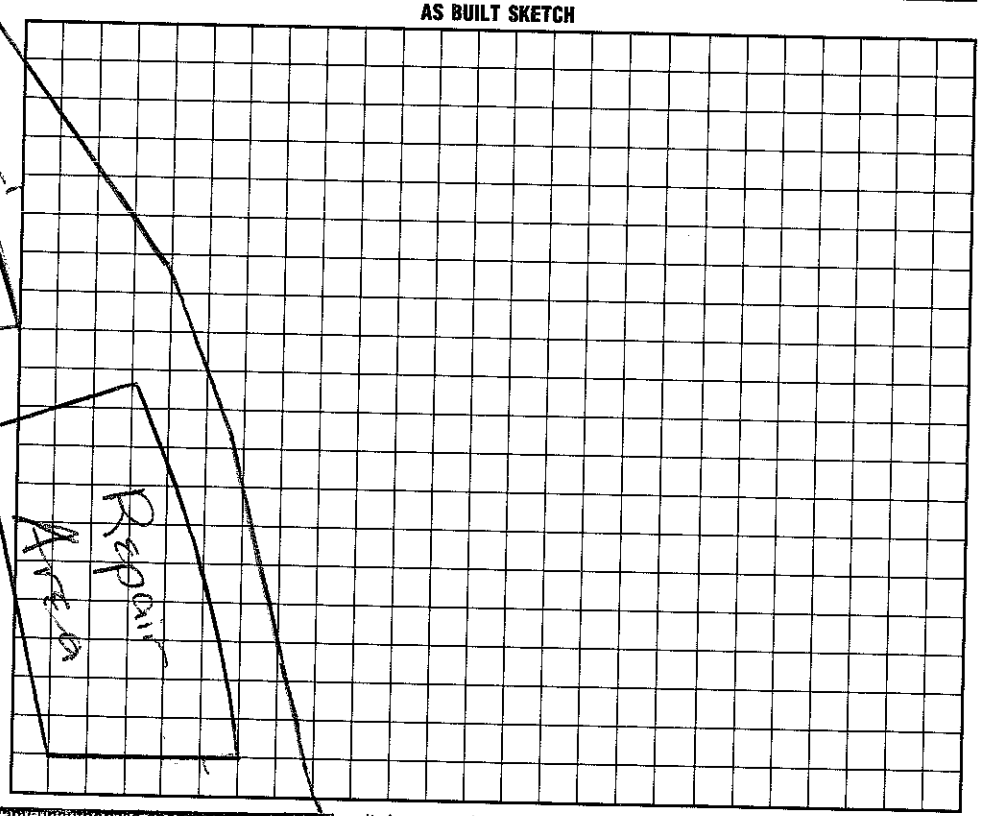

I understand that this permit can be suspended or revoked if any false information is supplied toward securing the permit/any unauthorized changes are made to the site/any unauthorized changes are made in the installation of the system. Improvement Permit is valid for 60 months from date of issuance.

Signed: _____

Improvement Permit by: Maria H H Dobson date 9/19/97

Existing System Inspection by: _____ date _____

Installed by: RICHARD ABERNATHY

Certificate of Completion by: _____ date _____

Operation Permit by: C. _____ date 2/10/98

HEALTH DEPT. COPY: WHITE INSPECTION COPY (FINAL): GREEN OWNER COPY (FINAL): YELLOW INSPECTION COPY (INITIAL): PINK OWNER COPY (INITIAL): GOLD