IREDELL COUNTY HEALTH DEPARTMENT

STATESVILLE 704-878-5305 MOORESVILLE 704-664-5281

IMPROVEMENT PERMIT / CERTIFICATE OF COMPLETION / OPERATION PERMIT / EXISTING SYSTEM INSPECTION

PROPERTY DESCRIPTION NO. 20678 DATE 5/23/95 TAX MAP NO. Pt of 2K-B-27 Watershed: [X] Yes [ ] No

OWNER OR CONTRACTOR Genesis Developers LTD. PHONE: Business 478-2952 ~~Home~~ 4646-26-6694

ADDRESS PO Box 44 Sherrills Ford, NC. 28673

LOCATION (L) on Shoreview Dr. off Sundown Rd. (L) Sunhaven Ct., 4th lot on (L)

SUBDIVISION LAKE VISTA BLOCK / SECTION 1 LOT 17 LOT AREA ~.98AC SITE CLASS. P DESIGN FLOW 480 L.T.A.R. .3

Septic Tank: 1000 Gallons; STB 986 Date 2/6/96

Pump Tank: _____ Gallons; PT _____ Date _____

Pump Make: _____ Model 1200 Ace Serial No. ~~X400~~ Ace 533

Nitrification Field: No Fields 1 Square Feet ~~1000~~ Linear Feet ~~400~~ (533)

No Lines 5 Trench Width 36" Max Trench Bottom Depth 36" Gravel Depth N/A

[X] New System [ ] Repair System Type: I, II, (III), IV, V, VI

System Description: Gravity - Infiltrator

Repair System Description: Same

Maintenance Agreement Required: [ ] Yes [X] No

[X] House/Mod. Home No. Bedrooms 4

[ ] Mobile Home No. Bathrooms 3

[ ] Business No. Employees _____

[ ] Other _____


[ ] Slab [X] Crawl Space [ ] Basement w/plumbing [ ] Basement wo/plumbing

Water Supply: [X] Individual [ ] Community [ ] Public


Comments: ~~X~~ 25% reduction for use of Infiltrator drainfield

Comments:

INITIAL SITE SKETCH

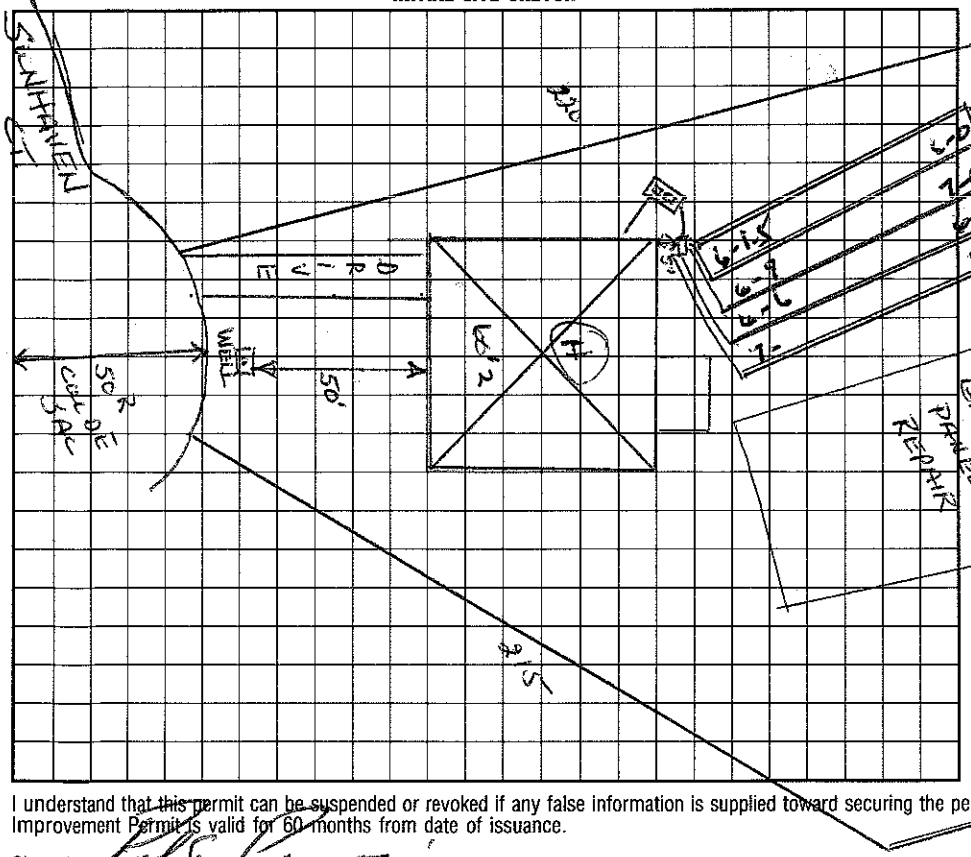

AS BUILT SKETCH

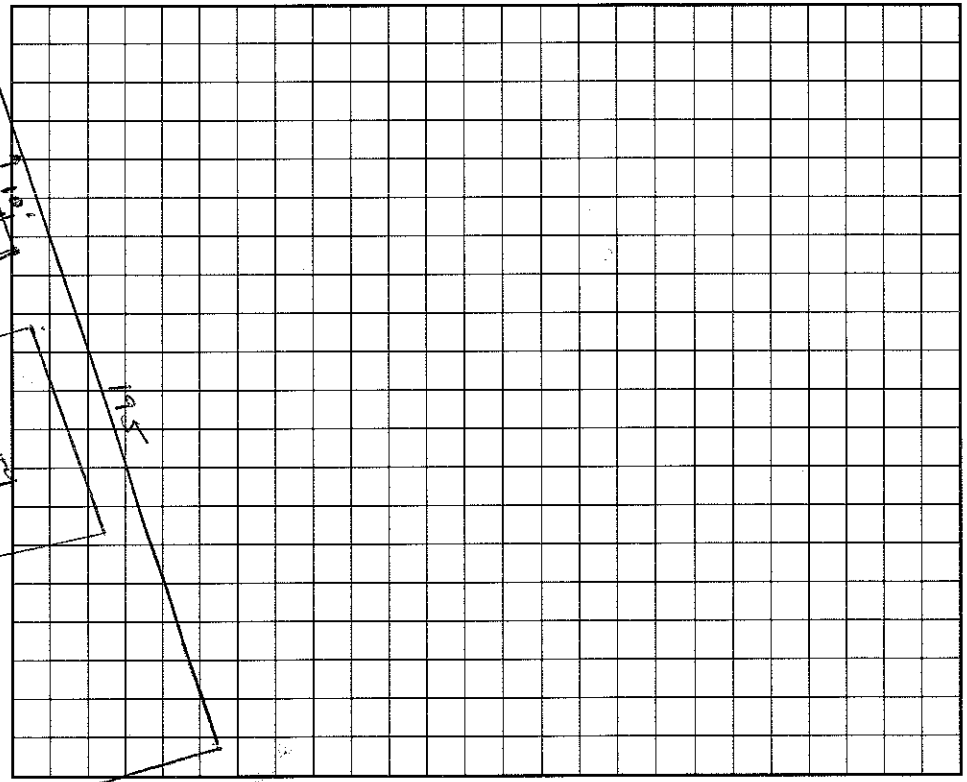

I understand that ~~this~~ permit can be suspended or revoked if any false information is supplied toward securing the permit/any unauthorized changes are made to the site/any unauthorized changes are made in the installation of the system. Improvement Permit is valid for 60 months from date of issuance.

Signed: _____

Improvement Permit by: Wesley Sparks RS date 5/23/95

Existing System Inspection by: _____ date _____

Installed by: Finger Landscaping

Certificate of Completion by: _____ date _____

Operation Permit by: Wesley Sparks R.S. date 7/1/96

HEALTH DEPT. COPY: WHITE INSPECTION COPY (FINAL): GREEN OWNER COPY (FINAL): YELLOW INSPECTION COPY (INITIAL): PINK OWNER COPY (INITIAL): GOLD