IREDELL COUNTY HEALTH DEPARTMENT

STATESVILLE 704-878-5305 MOORESVILLE 704-664-5281 SEND FK

IMPROVEMENT PERMIT / CERTIFICATE OF COMPLETION / OPERATION PERMIT / EXISTING SYSTEM INSPECTION

PROPERTY DESCRIPTION NO. 20679 DATE 5/17/95 TAX MAP NO. 2-K-B27 Pt of Watershed: ☐ Yes ☒ No

OWNER OR CONTRACTOR Genesis Developers LTD. ~~PHONE: Business~~ 4646-26-6789 Home 478-2952

ADDRESS PO Box 44 Sherrills Ford, NC. 28673

LOCATION Sundown Rd TR. on Shoreview Dr. TL on Sunhaven Ct. 3rd lot on (L)

SUBDIVISION Lake Vista BLOCK / SECTION ____ LOT 18 LOT AREA .66 AC SITE CLASS. P DESIGN FLOW 480 L.T.A.R. .3

Septic Tank: 1000 Gallons; STB 55 Date 2/19/97

Pump Tank: ____ Gallons; PT ____ Date ____

Pump Make: ____ Model ____ Serial No. 300

Nitrification Field: No Fields 1 Square Feet 1600 Linear Feet ~~400~~ X

No Lines ~~X~~3 Trench Width 36" Max Trench Bottom Depth 32" Gravel Depth ____

☒ New System ☐ Repair System Type: I, II, ☒ III, IV, V, VI

System Description: Gravity - Infiltrator

Repair System Description: Gravity - Panel

Maintenance Agreement Required: ☐ Yes ☒ No

☒ House/Mod. Home ☐ Mobile Home ☐ Business ☐ Other

No. Bedrooms ~~X~~3 No. Bathrooms 3 No. Employees ____


☐ Slab ☒ Crawl Space ☐ Basement w/plumbing ☐ Basement wo/plumbing

Water Supply: ☒ Individual ☐ Community ☐ Public


Comments: ~~X~~.25 reduction for use of Infiltrator drainfield installed on contours

Comments: Changed to 3 BDRm. Plat allocations drawn - 10/24/97 - System flagged - Ames.

INITIAL SITE SKETCH

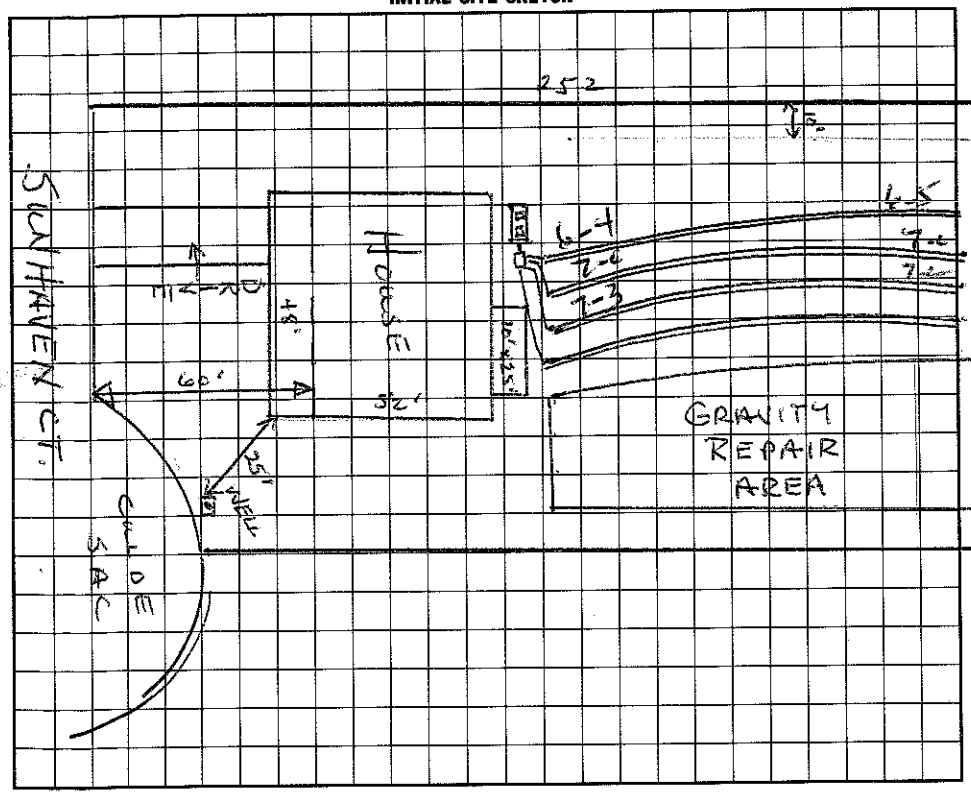

AS-BUILT SKETCH

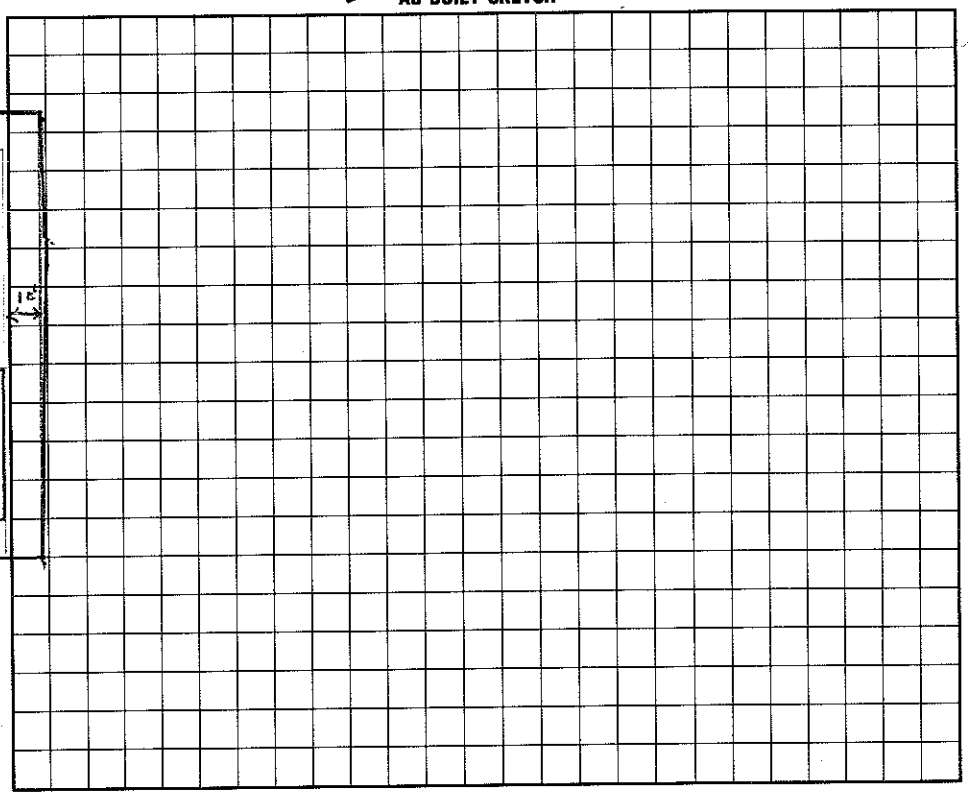

I understand that this permit can be suspended or revoked if any false information is supplied toward securing the permit/any unauthorized changes are made to the site/any unauthorized changes are made in the installation of the system. Improvement Permit is valid for 60 months from date of issuance.

Signed: Paul G. Kenny

Improvement Permit by: Wesley Sparks RS. date 5/17/95

Existing System Inspection by: ____ date ____

Installed by: Finger Lend Septic

Certificate of Completion by: Wesley Sparks RS date 4/21/97

Operation Permit by: Wesley Sparks RS date 4/21/97

HEALTH DEPT. COPY: WHITE INSPECTION COPY (FINAL): GREEN OWNER COPY (FINAL): YELLOW INSPECTION COPY (INITIAL): PINK OWNER COPY (INITIAL): GOLD