IREDELL COUNTY HEALTH DEPARTMENT

STATESVILLE 704-878-5305 MOORESVILLE 704-664-5281

IMPROVEMENT PERMIT / CERTIFICATE OF COMPLETION / OPERATION PERMIT / EXISTING SYSTEM INSPECTION

2nd

PROPERTY DESCRIPTION NO. 20682 DATE 5/17/95 TAX MAP NO. 2K B 27 Pt of Watershed: ☐ Yes ☑ No

OWNER OR CONTRACTOR Genesis Developers LTD. PHONE: Business 478-2952 ~~Home~~ 4646-26-6961

ADDRESS PO Box 44 Sherrills Ford, NC. 28673

LOCATION Sundown Rd, TR on Shoreview Dr. TL on Sunhaven Ct. 2nd lot on (L) 360 AWS

SUBDIVISION Lake Vista BLOCK / SECTION 1 LOT 19 LOT AREA .5 AC SITE CLASS. P. DESIGN FLOW ~~430~~ L.T.A.R. .3

Septic Tank: 1000 Gallons; STB 794 Date 10/12/96

Pump Tank: _____ Gallons; PT _____ Date _____

Pump Make: _____ Model _____ Serial No. AWS 300

Nitrification Field: No Fields 1 Square Feet 1600 Linear Feet ~~X 400~~

No Lines 4 Trench Width 36" Max Trench Bottom Depth 30" Gravel Depth _____

☑ New System ☐ Repair System Type: I, II, ☑ III, IV, V, VI

System Description: Infiltrator - Gravity

Repair System Description: Gravity - Panel

Maintenance Agreement Required: ☐ Yes ☑ No

☑ House/Mod. Home No. Bedrooms 4

☐ Mobile Home No. Bathrooms 3

☐ Business No. Employees ____

☐ Other _____

☐ Slab ☑ Crawl Space ☐ Basement w/plumbing ☐ Basement wo/plumbing


Water Supply: ☑ Individual ☐ Community ☐ Public

Comments: ~~X~~ .25 Reduction for use of Infiltrator

OK'd 4 (E) 75'x3' lines for 3 Bedroom Home AWS

Comments:

INITIAL SITE SKETCH

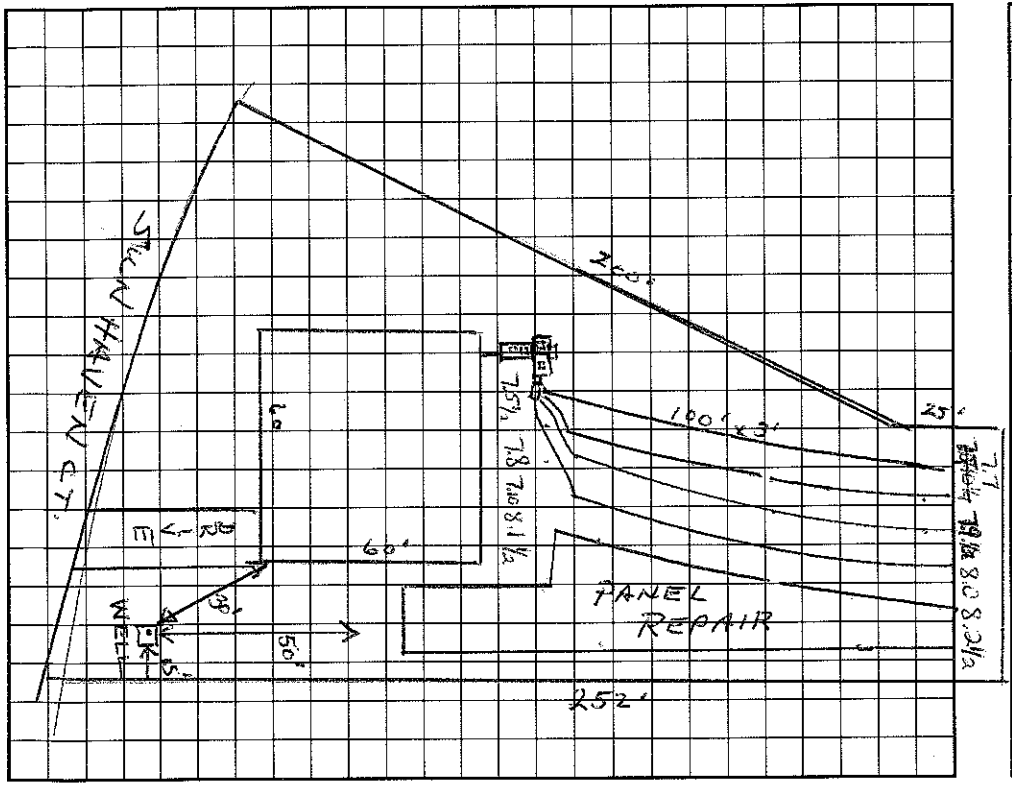

AS BUILT SKETCH

I understand that this permit can be suspended or revoked if any false information is supplied toward securing the permit/any unauthorized changes are made to the site/any unauthorized changes are made in the installation of the system. Improvement Permit is valid for 60 months from date of issuance.

Signed: _____

Improvement Permit by: Wesley Sparks R.S. date 5/17/95

Existing System Inspection by: _____ date _____

Installed by: Brad Russell

Certificate of Completion by: _____ date _____

Operation Permit by: Wesley Sparks R.S. date 1/3/97

HEALTH DEPT. COPY: WHITE INSPECTION COPY (FINAL): GREEN OWNER COPY (FINAL): YELLOW INSPECTION COPY (INITIAL): PINK OWNER COPY (INITIAL): GOLD