IREDELL COUNTY HEALTH DEPARTMENT

STATESVILLE 704-878-5305 MOORESVILLE 704-664-5281

IMPROVEMENT PERMIT / CERTIFICATE OF COMPLETION / OPERATION PERMIT / EXISTING SYSTEM INSPECTION

PROPERTY DESCRIPTION NO. 20688 DATE 4/23/95 TAX MAP NO. 2K B 27 Pt of Watershed: ☐ Yes ☑ No

OWNER OR CONTRACTOR Genesis Developers LTD. PHONE: Business 478-2952 ~~Home~~ 464-26-9610

ADDRESS PO Box 44 Sherrills Ford, NC. 28673

LOCATION Sundown Rd. on (R) past entrance

SUBDIVISION Lake Vista BLOCK / SECTION 1 LOT 25 LOT AREA ~.72 AC SITE CLASS. P DESIGN FLOW ~~480~~ 360 L.T.A.R. .35

Septic Tank: 1000 Gallons; STB 794 Date 4/30/97 ☑ New System ☐ Repair System Type I, II, (III), IV, V, VI ☑ House/Mod. Home No. Bedrooms 4 Water Supply:

Pump Tank: ______ Gallons; PT ______ Date ______ System Description: Gravity - Infiltrator ☐ Mobile Home No. Bathrooms 3 ☑ Individual

Pump Make: ______ Model ______ Serial No. ______ Repair System Description: Gravity Panel ☐ Business No. Employees ______ ☐ Community


Nitrification Field: No Fields 1 Square Feet 1371 Linear Feet 342 * Maintenance Agreement Required: ☐ Yes ☐ No ☐ Other ______ ☐ Public

No Lines 4 Trench Width 36" Max Trench Bottom Depth 36" Gravel Depth N/A ☐ Slab ☑ Crawl Space ☐ Basement w/plumbing ☐ Basement wo/plumbing

Comments: * .25 Reduction for Infiltrator use
Topo difficult slightly concave upslope diversion necessary.

Comments: [4 at 85' x 3']

INITIAL SITE SKETCH

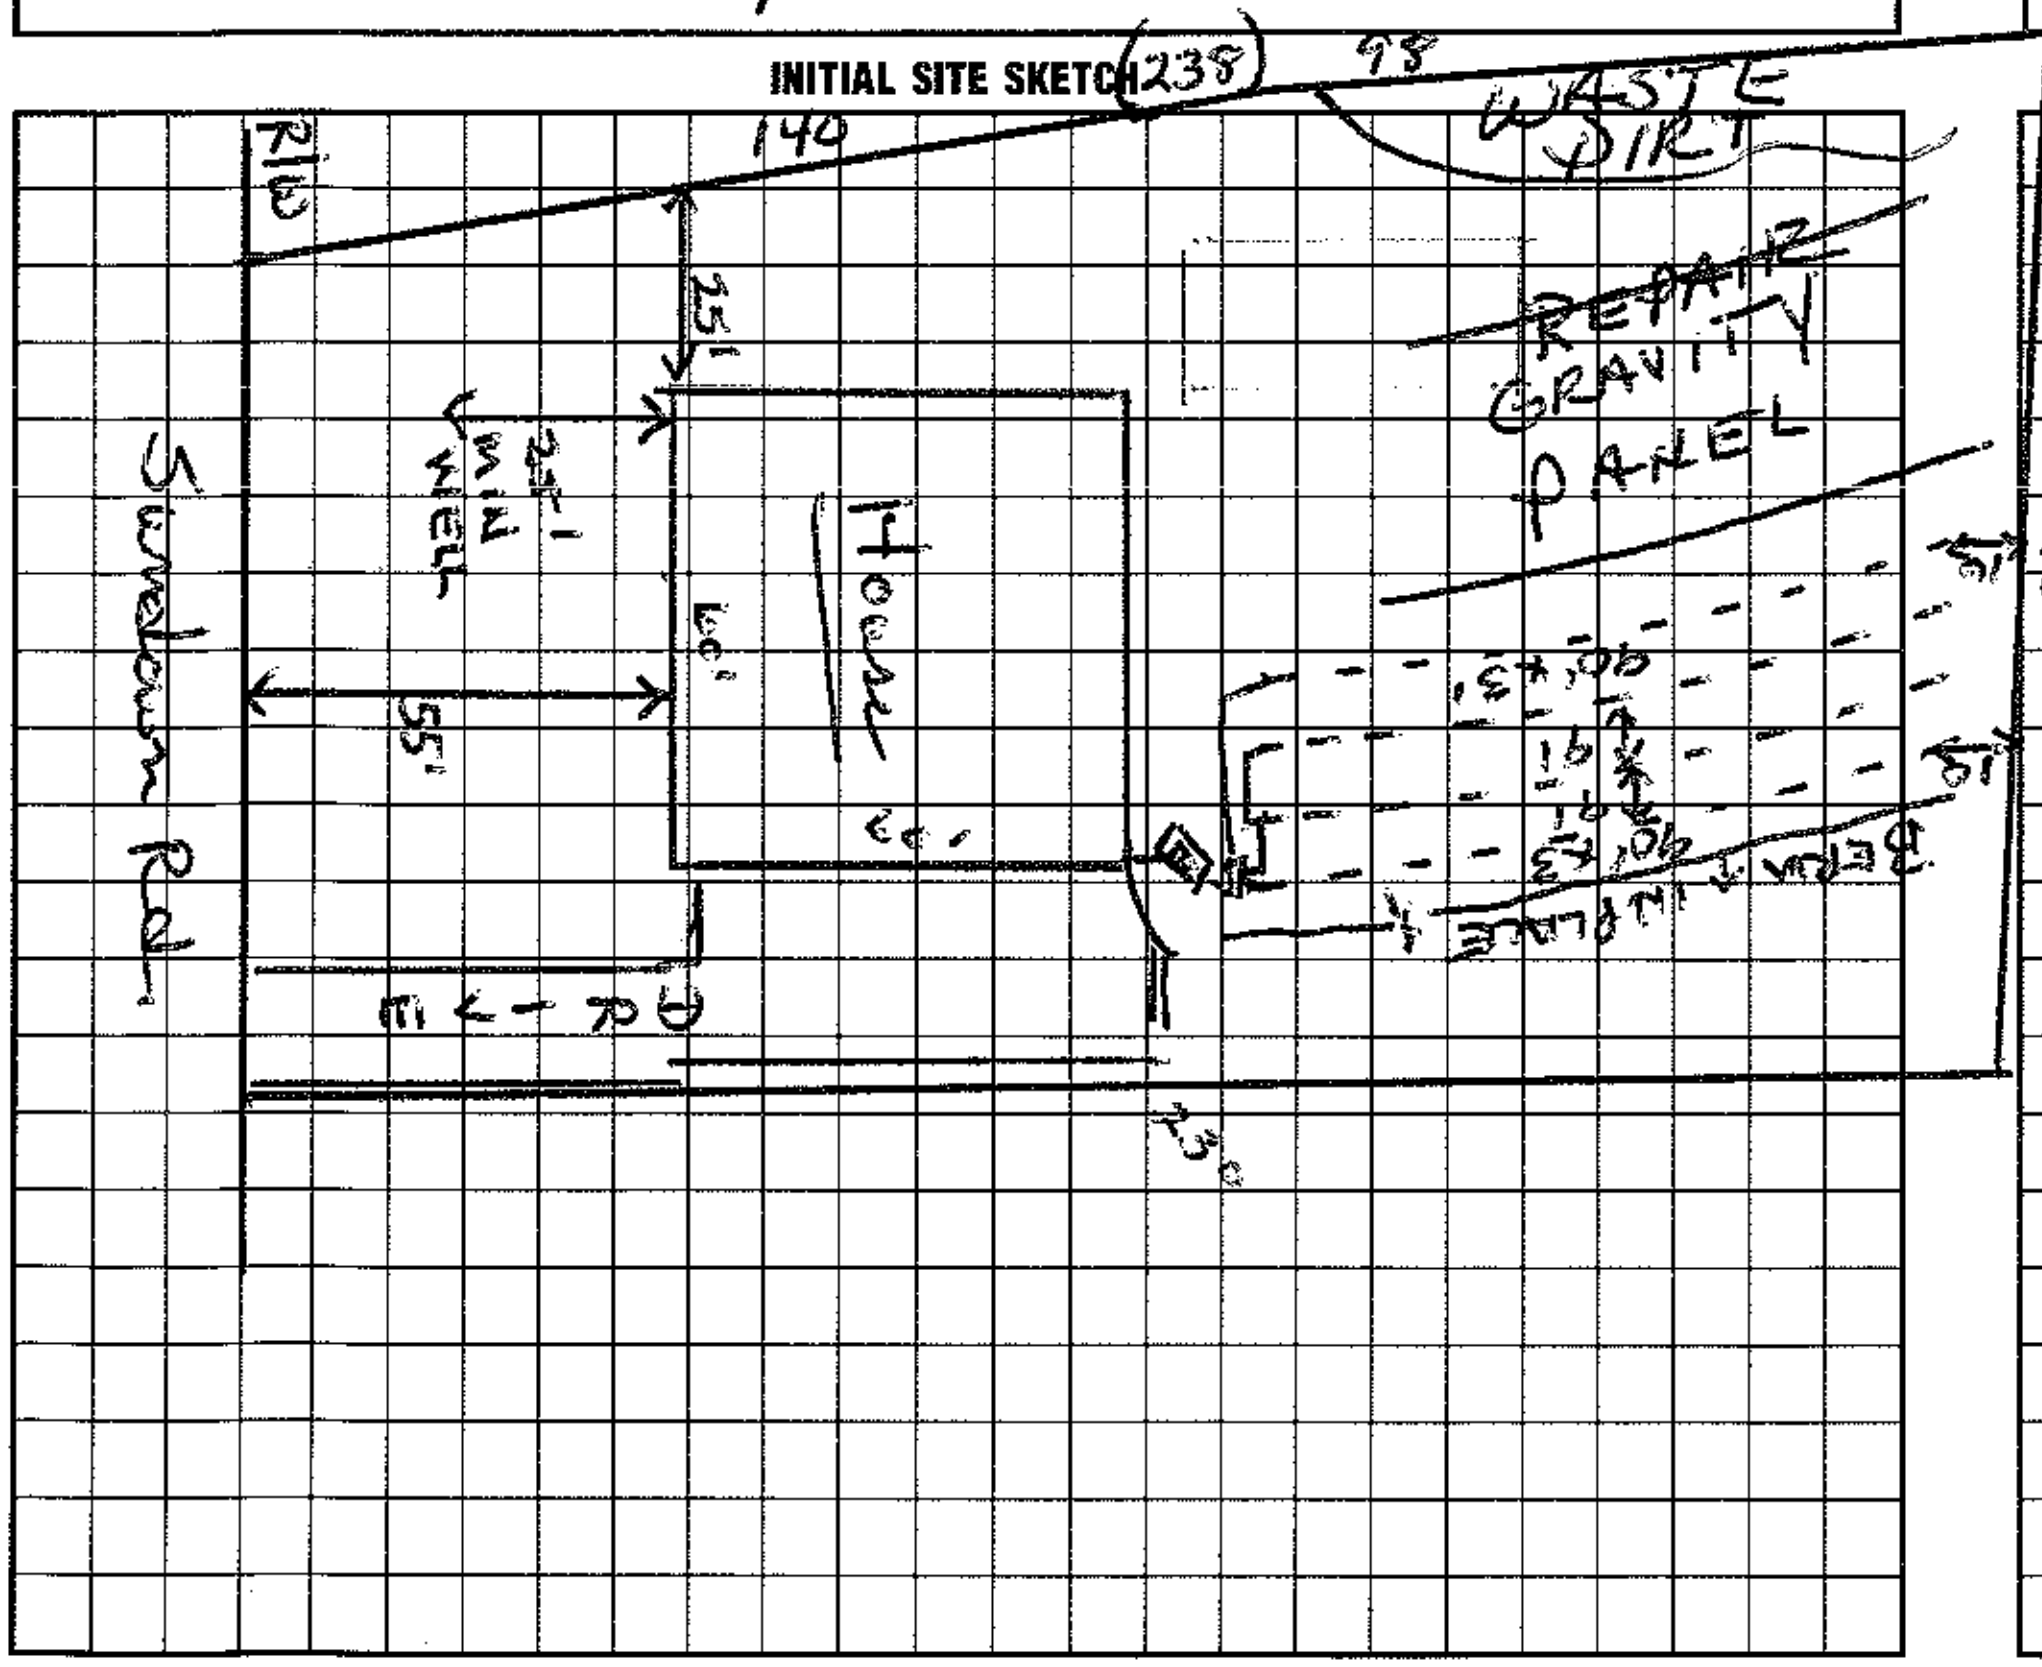

AS BUILT SKETCH

I understand that this permit can be suspended or revoked if any false information is supplied toward securing the permit/any unauthorized changes are made to the site/any unauthorized changes are made in the installation of the system. Improvement Permit is valid for 60 months from date of issuance.

Signed: [signature] Installed by: Moon House Grading

Improvement Permit by: Wesley Sparks RS. date 4/27/95 Certificate of Completion by: Wesley Sparks RS. date 6/6/97

Existing System Inspection by: ______ date ______ Operation Permit by: Wesley Sparks RS. date 6/6/97

HEALTH DEPT. COPY: WHITE INSPECTION COPY (FINAL): GREEN OWNER COPY (FINAL): YELLOW INSPECTION COPY (INITIAL): PINK OWNER COPY (INITIAL): GOLD