IREDELL COUNTY HEALTH DEPARTMENT

STATESVILLE 704-878-5305 MOORESVILLE 704-664-5281

IMPROVEMENT PERMIT / AUTHORIZATION TO CONSTRUCT / OPERATION PERMIT / EXISTING SYSTEM INSPECT.

PERMIT# 20686 PIN# 2K B 27 / 4635-80-7555 DATE 4/1/99

OWNER OR CONTRACTOR Richardson Homes PHONE: Business 704-843-4637 Home

ADDRESS 4724 Parkwood Sch. Rd. Monroe, N.C. 28112

LOCATION Sundown Rd. on (R) just past Shoreview Dr.

SUBDIVISION Lake Vista BLOCK / SECTION LOT 23 LOT AREA .63 Ac SITE CLASS. PS DESIGN FLOW 360 L.T.A.R. .3

Septic Tank: 1000 Gallons; STB 312 Date 4/29/99
Pump Tank: Gallons; PT Date
Pump Make: Model Serial No.
Nitrification Field: No Fields 1 Square Feet 1200 Linear Feet 400
No Lines X 5 Trench Width 36" Max Trench Bottom Depth 36" Gravel Depth 12"

☒ New System ☐ Repair System Type: I, (II) III, IV, V, VI
System Description: Gravity - Conventional
Repair System Description: Gravity - Panel
Maintenance Agreement Required: ☐ Yes ☒ No


☒ House/Mod. Home No. Bedrooms 3
☐ Mobile Home No. Bathrooms 2
☐ Business No. Employees
☐ Other
☐ Slab ☒ Crawl Space ☐ Basement w/plumbing ☐ Basement wo/plumbing

Water Supply:
☒ Individual
☐ Public
☐ Community

Comments:/Conditions:

Comments:/Conditions:

INITIAL SITE SKETCH

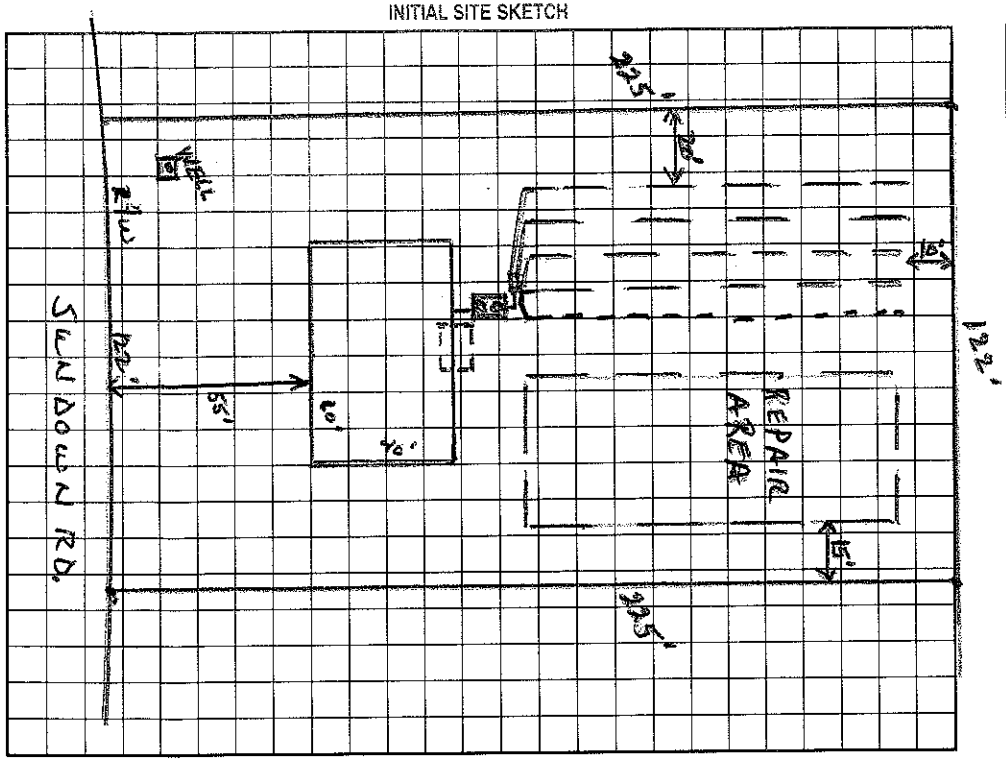

AS BUILT SKETCH

Permit can be suspended or revoked if any false information is supplied toward securing the permit/any unauthorized changes are made to the site/any unauthorized changes are made in the installation of the system. Improvement Permit with plat valid without expiration. Improvement Permit with site plan valid for sixty months. Authorization to Construct is valid for a period equal to that of Improvement Permit – not to exceed sixty months.

Signed: * J.A. McFall date 4/6/99

Improvement Permit by: Wesley Sparks RS date 4/1/99

Authorization to Construct by: Wesley Sparks RS. date 4/1/99

Installed by: Curt Dunning

Operation Permit by: Wesley Sparks RS. date 8/12/99

Existing System Inspection by: date

HEALTH DEPT. COPY: WHITE OWNER COPY (FINAL): YELLOW OWNER COPY (INITIAL): PINK