IREDELL COUNTY HEALTH DEPARTMENT

STATESVILLE 704-878-5305 · MOORESVILLE 704-664-5281

IMPROVEMENT PERMIT / AUTHORIZATION TO CONSTRUCT / OPERATION PERMIT / EXISTING SYSTEM INSPECTION

PERMIT# 106183 PIN# ~~4646 20 46 11.73~~ 4646270811 DATE 12/10/03

OWNER OR CONTRACTOR Ryan Homes PHONE: Business 704-875-4887 Home

ADDRESS 9920 Kincey Ave. Huntersville NC 28078

LOCATION Williamson, TR Sundown, TR Sundown Cove TL Corona Cir on Lt. 203

SUBDIVISION Est @ Sundown BLOCK / SECTION LOT B LOT AREA 30,059 Ft² SITE CLASS. PS DESIGN FLOW 480 L.T.A.R. @ 0.25

Septic Tank: 1000 Gallons; STB 794 Date 1-3-04
Pump Tank: 1000 Gallons; PT ~~F 5 04~~ 827 Date 4-5-04
Pump Make: Myers Model ME50S Serial No.
Nitrification Field: No Fields 1 Square Feet 960 Linear Feet 320'
No Lines 3 Trench Width 24" Max Trench Bottom Depth 36" Gravel Depth —

☒ New System ☐ Repair System Type: I, II, III, IV, V, VI
System Description: LP Panel Block
Repair System Description: Same
Maintenance Agreement Required: ☒ Yes ☐ No


☒ House/Mod. Home No. Bedrooms 4
☐ Mobile Home No. Bathrooms 4
☐ Business No. Employees
☐ Other
☐ Slab ☐ Crawl Space ☒ Basement w/plumbing ☐ Basement wo/plumbing

Water Supply:
☐ Individual
☐ Public
☐ Community


Comments/Conditions:
1"=50' Line may need to move back some to make room For House

Comments/Conditions: Checked tanks & 2 of 3 lines
Checked 3rd line 5/17/04
Pressure, float & alarm checked 5/24/04

INITIAL SITE SKETCH

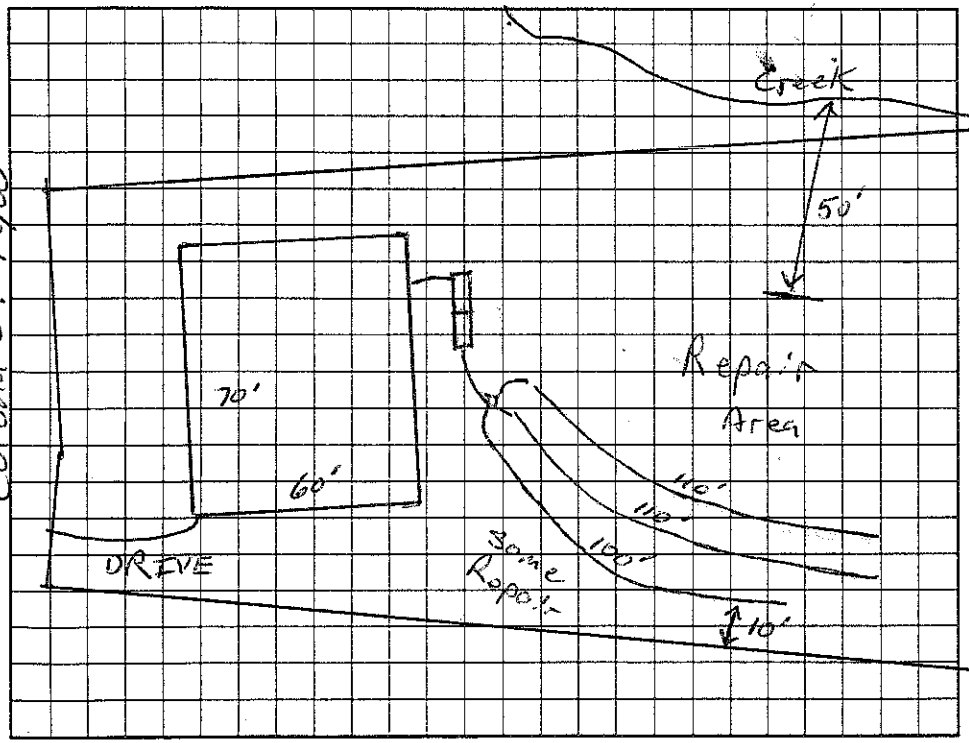

AS BUILT SKETCH

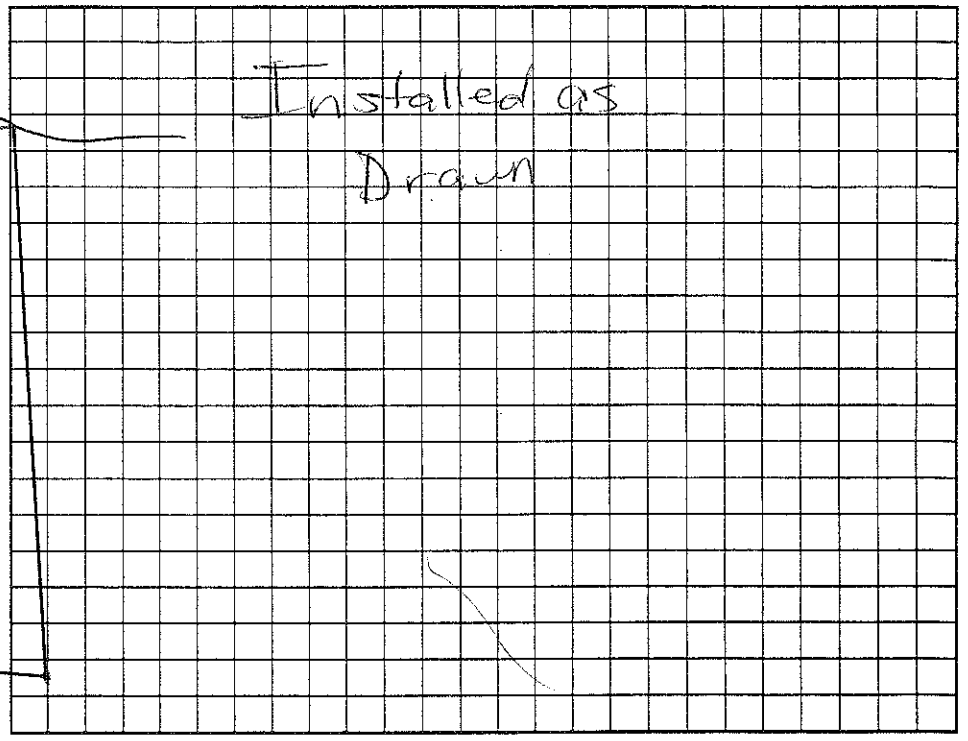

Permit can be suspended or revoked if any false information is supplied toward securing the permit/any unauthorized changes are made to the site/any unauthorized changes are made in the installation of the system. Improvement Permit with plat valid without expiration. Improvement Permit with site plan valid for sixty months. Authorization to Construct is valid for a period equal to that of Improvement Permit – not to exceed sixty months.

Signed: Tony C Jones date 12-10-03 Installed by: R & H

Improvement Permit by: RS date 12/10/03 Operation Permit by: RS date 5/27/04

Authorization to Construct by: RS date 1/20/04 Existing System Inspection by: date

HEALTH DEPT. COPY: WHITE OWNER COPY (FINAL): YELLOW OWNER COPY (INITIAL): PINK