4646-27-1477

2 30

IREDELL COUNTY HEALTH DEPARTMENT

STATESVILLE 704-878-5305 MOORESVILLE 704-664-5281

IMPROVEMENT PERMIT / CERTIFICATE OF COMPLETION / OPERATION PERMIT / EXISTING SYSTEM INSPECTION

PROPERTY DESCRIPTION NO. 20693 DATE 5/18/95 TAX MAP NO. 2K B 27 Pt. of. Watershed: ☐ Yes ☑ No

OWNER OR CONTRACTOR Lonesome Development PHONE: Business 478-2952 Home

ADDRESS Po Box 44 Sherrills Ford, NC. 28673 412 Sundown Rd. Mooresville, NC. 28115

LOCATION Sundown Rd. to back side of Lake Vista on (R) before driveway. way

SUBDIVISION Lake Vista BLOCK / SECTION LOT 29 LOT AREA ~.88AC. SITE CLASS. P. DESIGN FLOW 480 L.T.A.R. .3

Septic Tank: 1000 Gallons; STB 794 Date 8/19/97

Pump Tank: 1000 Gallons; PT 27 Date 9/22/97

Pump Make: Model Serial No.

Nitrification Field: No. Fields 1 Square Feet 1600 Linear Feet 533 (266) X

No. Lines X3 Trench Width 24" Max Trench Bottom Depth 32" Gravel Depth 6" SAND

☑ New System ☐ Repair System Type: I, II, III, (IV) V, VI

System Description: Pres. Panel

Repair System Description: Same

Maintenance Agreement Required: ☑ Yes ☐ No

☑ House/Mod. Home No. Bedrooms 4

☐ Mobile Home No. Bathrooms 3

☐ Business No. Employees

☐ Other


☐ Slab ☐ Crawl Space ☒ Basement w/plumbing ☐ Basement wo/plumbing

Water Supply: ☑ Individual ☐ Community ☐ Public

Comments: X 12" Pressure Panel
4/7/97 - Tanks Relocated to lower end of lower - AWS.

Comments:
7.0-7.5 Doze
Wm. Wisnewsker - Homeowner.

INITIAL SITE SKETCH

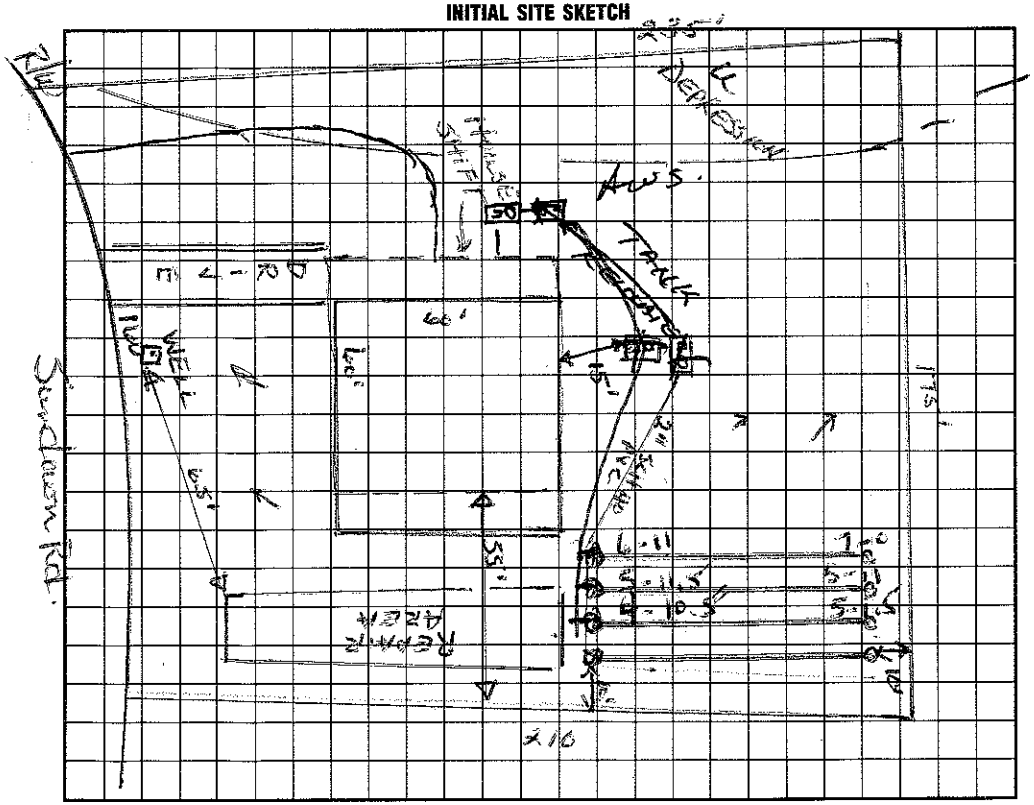

AS BUILT SKETCH

I understand that this permit can be suspended or revoked if any false information is supplied toward securing the permit/any unauthorized changes are made to the site/any unauthorized changes are made in the installation of the system. Improvement Permit is valid for 60 months from date of issuance.

Signed: Earl A. Berger

Improvement Permit by: Wesley Sparks RS. date 5/18/95

Existing System Inspection by: date

Installed by: Lavon Benton

Certificate of Completion by: Wesley Sparks RS. date 11/6/97

Operation Permit by: Wesley Sparks RS date 11/6/97

HEALTH DEPT. COPY: WHITE INSPECTION COPY (FINAL): GREEN OWNER COPY (FINAL): YELLOW INSPECTION COPY (INITIAL): PINK OWNER COPY (INITIAL): GOLD