IREDELL COUNTY HEALTH DEPARTMENT

STATESVILLE 704-878-5305 MOORESVILLE 704-664-5281

IMPROVEMENT PERMIT / CERTIFICATE OF COMPLETION / OPERATION PERMIT / EXISTING SYSTEM INSPECTION

PROPERTY DESCRIPTION NO. 20691 DATE 4/23/95 TAX MAP NO. 2K B Pt 6 27 4646 27 2273 Watershed: ☐ Yes ☑ No

OWNER OR CONTRACTOR Genesis Developers LTD (MARTIS HOMES) PHONE: Business 478-2952 Home

ADDRESS Po Box 44 Sherrills Ford, NC. 28673

LOCATION Dundonor Rd.

SUBDIVISION Lake Vista BLOCK / SECTION 1 LOT 27 LOT AREA .69 AC SITE CLASS. P DESIGN FLOW 480 L.T.A.R. .3

Septic Tank: 1000 Gallons; STB 794 Date 11/8/99

Pump Tank: 1000 Gallons; PT 27 Date 5/25/99

Pump Make: ZOELLER Model .5 HP Serial No.

Nitrification Field: No Fields 1 Square Feet 1600 Linear Feet 400 x

No Lines 4 Trench Width 36" Max Trench Bottom Depth 34" Gravel Depth N/A

☑ New System ☐ Repair System Type: I, II, (III), IV, V, VI

System Description: Press - Manifold Aeration

Repair System Description: Press - Panel

Maintenance Agreement Required: ☐ Yes ☑ No

☑ House/Mod. Home No. Bedrooms 4

☐ Mobile Home No. Bathrooms 3

☐ Business No. Employees

☐ Other


☐ Slab ☑ Crawl Space ☐ Basement w/plumbing ☐ Basement wo/plumbing

Water Supply: ☑ Individual ☐ Community ☐ Public

Comments: * 25% reduction for Manifold Aeration
Washer Box w/ Auto Valve to pick before Last Box

Comments:

INITIAL SITE SKETCH

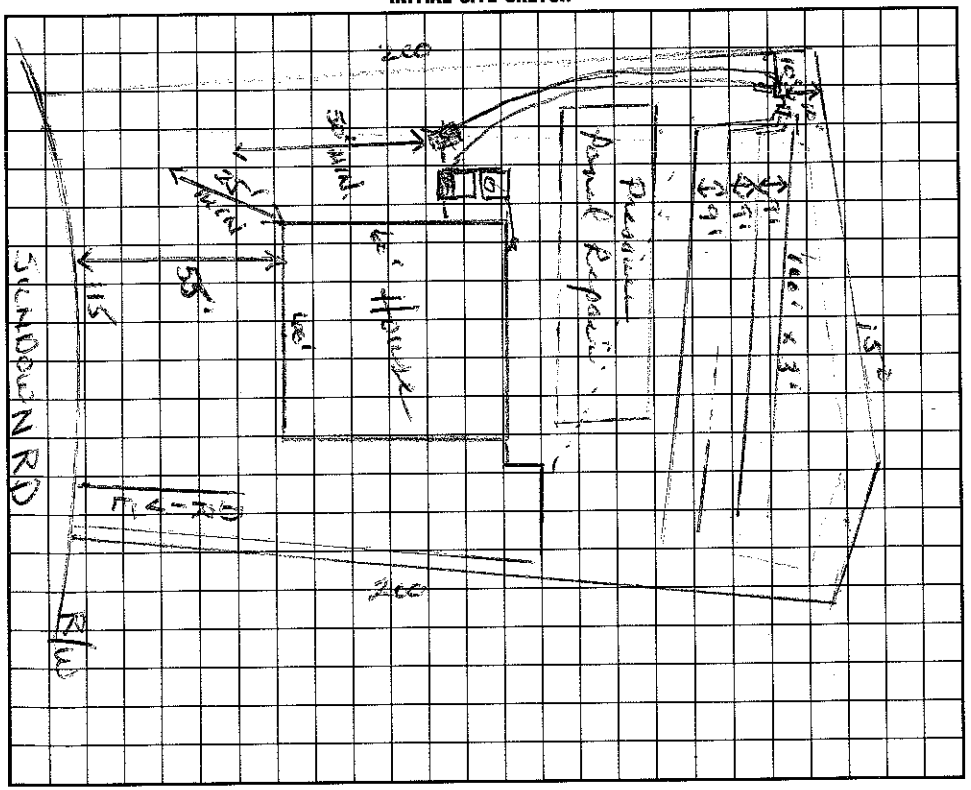

AS BUILT SKETCH

The proposed / existing SCREENED PORCH addition does not appear to impact the existing septic system.

**NOTE:

Wesley Sparks R.S.

Date: 8/5/09

ICHD-Environmental Health Division

I understand that this permit can be suspended or revoked if any false information is supplied toward securing the permit/any unauthorized changes are made to the site/any unauthorized changes are made in the installation of the system. Improvement Permit is valid for 60 months from date of issuance.

Signed:

Improvement Permit by: Wesley Sparks R.S. date 4/27/95

Existing System Inspection by: date

Installed by: READE ENDY

Certificate of Completion by: Wesley Sparks R.S. date 10/26/99

Operation Permit by: Wesley Sparks R.S. date 10/26/99

HEALTH DEPT. COPY: WHITE INSPECTION COPY (FINAL): GREEN OWNER COPY (FINAL): YELLOW INSPECTION COPY (INITIAL): PINK OWNER COPY (INITIAL): GOLD