IREDELL COUNTY HEALTH DEPARTMENT

STATESVILLE 704-878-5305 MOORESVILLE 704-664-5281

IMPROVEMENT PERMIT / CERTIFICATE OF COMPLETION / OPERATION PERMIT / EXISTING SYSTEM INSPECTION

PROPERTY DESCRIPTION NO. 20664 DATE 6/5/95 TAX MAP NO. 2K-B-27 Pt of Watershed: [X] Yes [ ] No

OWNER OR CONTRACTOR Genesis Developers LTD PHONE: Business 478-2952 ~~Home 4435-8044168~~

ADDRESS PO Box 44 Sherrills Ford, NC. 28673 4446-27-3586

LOCATION Sundown Rd. TR Shoreview Dr. to cul de sac ahead (L) of center

SUBDIVISION LAKE VISTA BLOCK / SECTION 1 LOT 7 LOT AREA .5 AC SITE CLASS. P DESIGN FLOW 480 L.T.A.R. .3

Septic Tank: 1000 Gallons; STB 794 Date 5/24/96

Pump Tank: _____ Gallons; PT _____ Date _____

Pump Make: _____ Model _____ Serial No. _____

Nitrification Field: No Fields 1 Square Feet 1600 Linear Feet 400 (533)

No Lines 4 Trench Width 36" Max Trench Bottom Depth 36" Gravel Depth N/A

[X] New System [ ] Repair System Type: I, II, (III) IV, V, VI

System Description: GRAV - INFILTRATOR

Repair System Description: GRAV - PANEL

Maintenance Agreement Required: [ ] Yes [X] No

[X] House/Mod. Home No. Bedrooms 4

[ ] Mobile Home No. Bathrooms 3

[ ] Business No. Employees _____

[ ] Other _____


[ ] Slab [X] Crawl Space [ ] Basement w/plumbing [ ] Basement wo/plumbing

Water Supply: [X] Individual [ ] Community [ ] Public

Comments: 25% reduction in size due to INFILTRATOR use.

Comments:

INITIAL SITE SKETCH

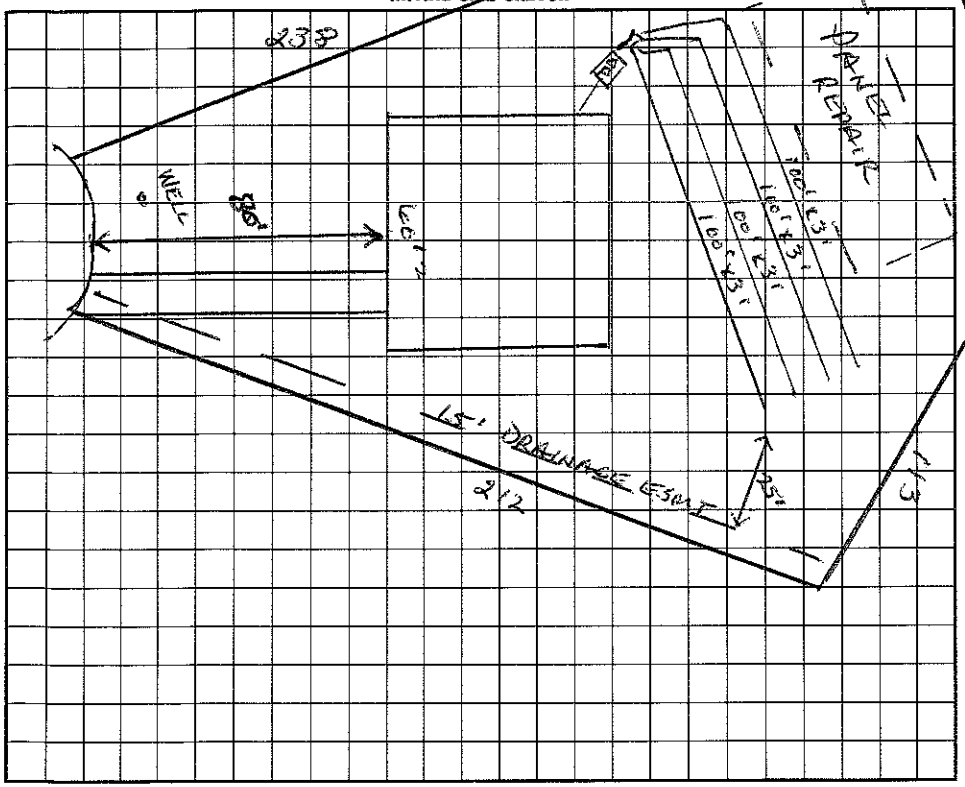

AS BUILT SKETCH

I understand that this permit can be suspended or revoked if any false information is supplied toward securing the permit/any unauthorized changes are made to the site/any unauthorized changes are made in the installation of the system. Improvement Permit is valid for 60 months from date of issuance.

Signed: _____

Improvement Permit by: Wesley Sparks RS. date 6/5/95

Existing System Inspection by: _____ date _____

Installed by: Allen House

Certificate of Completion by: _____ date _____

Operation Permit by: Wesley Sparks R.S. date 8/22/96

HEALTH DEPT. COPY: WHITE INSPECTION COPY (FINAL): GREEN OWNER COPY (FINAL): YELLOW INSPECTION COPY (INITIAL): PINK OWNER COPY (INITIAL): GOLD