IREDELL COUNTY HEALTH DEPARTMENT

STATESVILLE 704-878-5305 MOORESVILLE 704-664-5281

IMPROVEMENT PERMIT / AUTHORIZATION TO CONSTRUCT / OPERATION PERMIT / EXISTING SYSTEM INSPECTION

$50 11:30

PERMIT# 106184 PIN# 4646204611, 12 4646273728 DATE 5/5/03

OWNER OR CONTRACTOR Ryan Homes PHONE: Business 309-0123 Home 704-875-9887

ADDRESS 9920 Kincey Ave Ste 110 Huntersville NC 28078

LOCATION Williamson TR Sundown, TR Sundown Cove, TR Coronet

SUBDIVISION Est @ Sundown BLOCK / SECTION 2 LOT 12/12A LOT AREA 25,000 Ft2 SITE CLASS. PS DESIGN FLOW 600 L.T.A.R. 0.25

Septic Tank: 1500 Gallons; STB 338 Date 6-9-03

Pump Tank: 1500 Gallons; PT 338 Date 6-9-03

Pump Make: Myers Model P102 Serial No.

Nitrification Field: No Fields 1 Square Feet 1500 Linear Feet 600'

No Lines 5 6/12 Trench Width 36" Max Trench Bottom Depth 36" Gravel Depth —

☒ New System ☐ Repair System Type: I, II, III, IV, V, VI

System Description: Pump 25% reduction offsite

Repair System Description: LP Panel offsite

Maintenance Agreement Required: ☐ Yes ☒ No

☒ House/Mod. Home ☐ Mobile Home ☐ Business ☐ Other

No. Bedrooms 5 No. Bathrooms 5 No. Employees


Water Supply: ☐ Individual ☐ Public ☒ Community

☐ Slab ☒ Crawl Space ☐ Basement w/plumbing ☐ Basement wo/plumbing


Comments:/Conditions:

Comments:/Conditions:

INITIAL SITE SKETCH

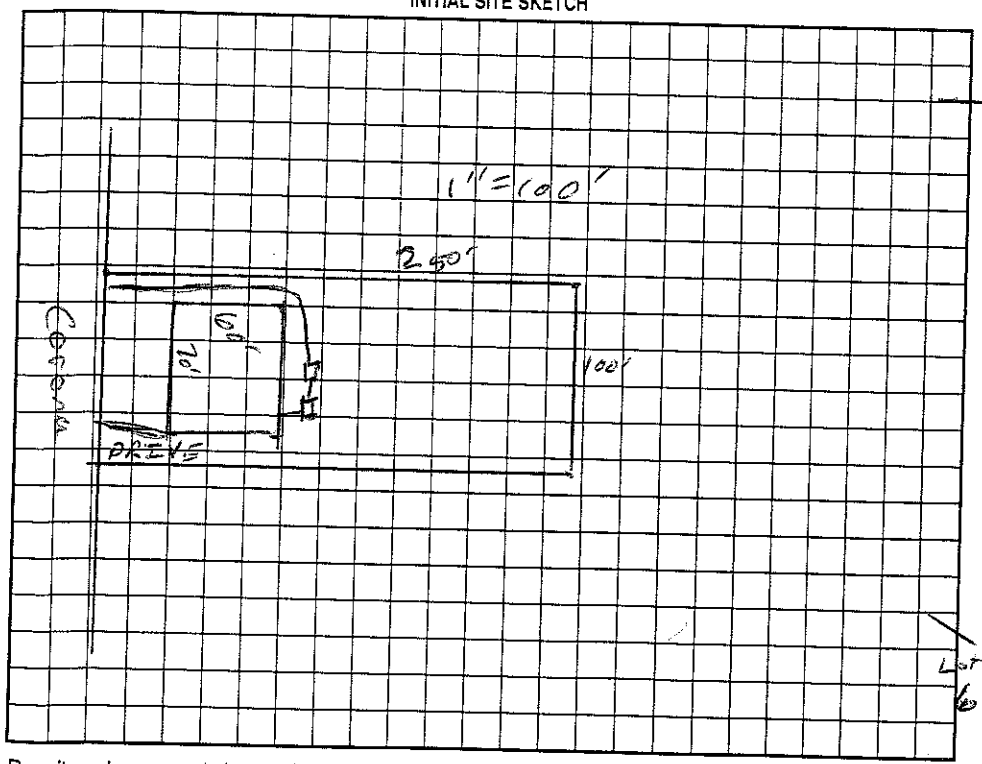

AS BUILT SKETCH

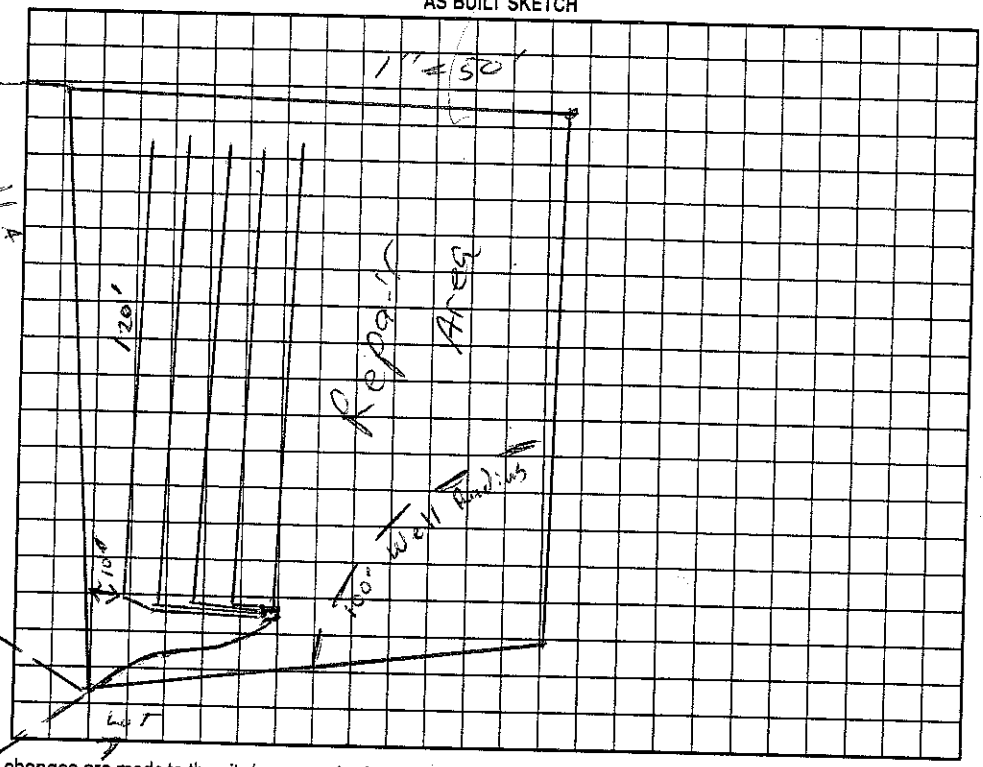

Permit can be suspended or revoked if any false information is supplied toward securing the permit/any unauthorized changes are made to the site/any unauthorized changes are made in the installation of the system. Improvement Permit with plat valid without expiration. Improvement Permit with site plan valid for sixty months. Authorization to Construct is valid for a period equal to that of Improvement Permit – not to exceed sixty months.

Signed: WAYNE F LOWER date 5-10-03

Improvement Permit by: RS date 5/5/03

Authorization to Construct by: RS date 5/5/03

Installed by: R & H Inc

Operation Permit by: Mark H Dotson RS date 7/24/03

Existing System Inspection by: date

HEALTH DEPT. COPY: WHITE OWNER COPY (FINAL): YELLOW OWNER COPY (INITIAL): PINK