IREDELL COUNTY HEALTH DEPARTMENT - *ENVIRONMENTAL HEALTH* ☐ STATESVILLE OFFICE 704-878-5305 ☒ MOORESVILLE OFFICE 704-664-5281

IMPROVEMENT PERMIT / AUTHORIZATION TO CONSTRUCT / OPERATION PERMIT / EXISTING SYSTEM INSPECTION Entered

PERMIT # 167379 PIN # 4646-27-4087 DATE 7-11-11

OWNER SCOTT & DANA FRIESINGER APPLICANT: EDGE BUILDING CO. PHONE: Home/Cell # 980-721-6778 Business #

SITE ADDRESS 108 SUNHAVEN LN OWNER / APPLICANT ADDRESS

SITE DIRECTIONS SUNDOWN, TR SHOREVIEW, TL SUN HAVEN, (R)

SUBDIVISION LAKE VISTA BLOCK / SECTION LOT # 11 LOT AREA .59 AC DESIGN FLOW 480 L.T.A.R. 3

Septic Tank Ex. 1000 Gallons: STB Date

Pump Tank Gallons: P T Date

Pump Make Model Serial #

No. Nitrification Fields: No. Lines Linear Feet

Trench Width Max. Trench Bottom Depth Gravel Depth

☐ New System ☐ Repair ☐ Expansion System Type I II (III) IV V VI

System Description: 25% REDUCTION

Repair System Description: LP- PANEL BLOCK

Maintenance Agreement Required ☐ YES ☒ NO INITIALLY

☒ GRAVITY ☐ PRESSURE

☒ Residence No. Bedrooms 4

☐ Business No. Persons

☒ Other No. Employees

☐ Slab ☒ Crawl Space

☐ Basement w/plumbing ☐ Basement w/o plumbing

Water Supply

☒ Private

☐ Public


☐ Community

Comments / Conditions


EXISTING

SHED

INITIAL SITE SKETCH

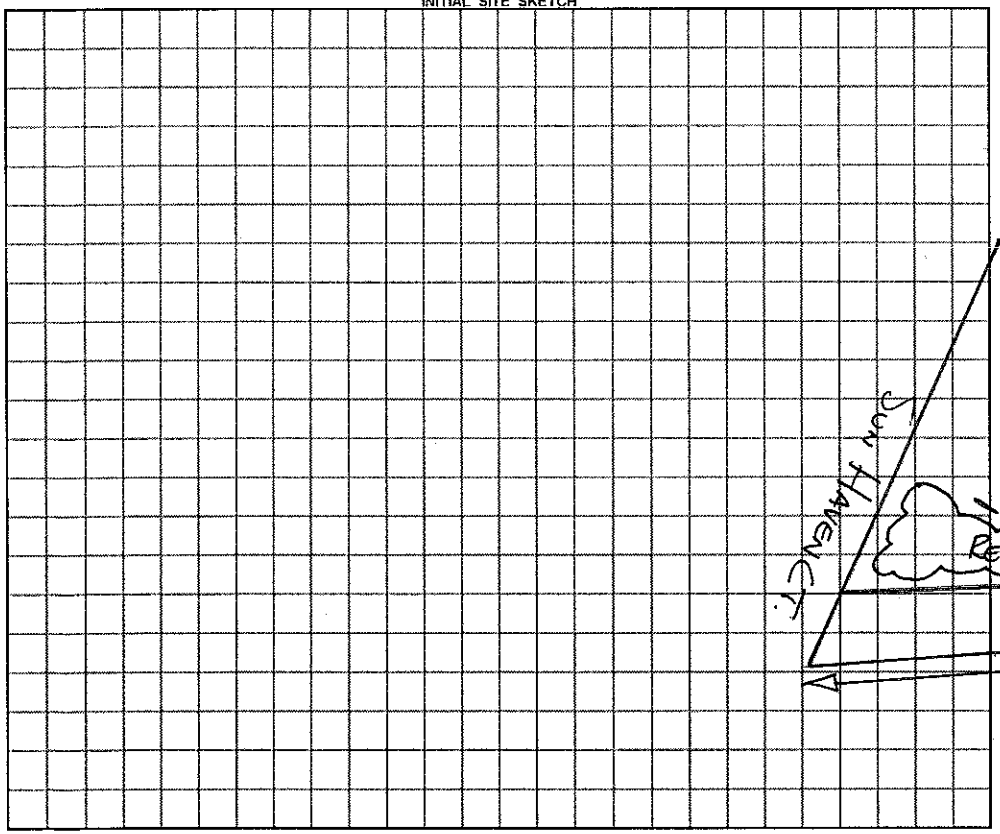

AS BUILT SKETCH

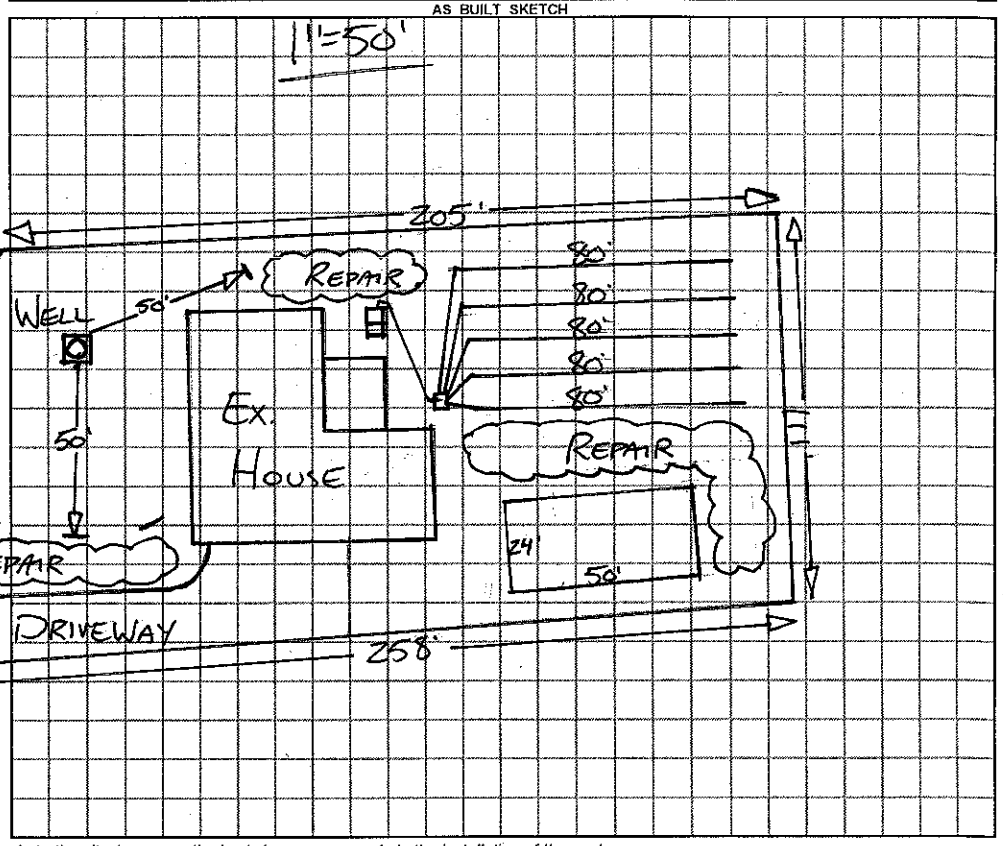

Permit can be suspended or revoked if any false information is supplied toward securing the permit / any unauthorized changes are made to the site / any unauthorized changes are made in the installation of the system.

☐ ***IMPROVEMENT PERMIT*** with plat valid without expiration. ☐ ***IMPROVEMENT PERMIT*** with ~~plat valid without expiration.~~ site plan valid 60 mo. ☐ ***AUTHORIZATION TO CONSTRUCT*** valid for period equal to IMPROVEMENT PERMIT--not to exceed 60 mo.

Owner / Applicant Signature: Date 7/15/11 Installed by:

IMPROVEMENT PERMIT by: REHS Date OPERATION PERMIT by: REHS Date

AUTHORIZATION TO CONSTRUCT by: REHS Date Existing System Inspected by: REHS Date 7-11-11

YOU SHOULD CONTACT A LOCATOR SERVICE PRIOR TO ANY EXCAVATION

White Copy -- Environmental Health YELLOW COPY (Final) Owner / Applicant PINK COPY (Initial) Owner / Applicant

IREDELL COUNTY HEALTH DEPARTMENT — STATESVILLE 704-878-5300

IMPROVEMENT PERMIT / AUTHORIZATION TO CONSTRUCT / OPERATION PERMIT / EXISTING SYSTEM INSPECTION

PERMIT # 154524 PIN # 4646274087 DATE 1-30-2009

OWNER or APPLICANT J&K Developers / Dana Friesleger PHONE: Business 336 469 2180 Home: 704 664-2064

OWNER or APPLICANT ADDRESS 3843 Gordon St. Tenstill, NC 28682

LOCATION / DIRECTIONS Brawley School Rd TL Williamson TR Sundown Rd TR Shoreview Dr TL Sunhaven Ct. 1st lot on Right

SUBDIVISION Lake Vista BLOCK / SECTION LOT # 11 LOT AREA .72 Acre DESIGN FLOW 480gpd I.T.A.R. .3

Septic Tank 1000 Gallons: STB Date

Pump Tank Gallons: PT Date

Pump Make Model Serial #

Verification Field No Fields 1 No Lines 5 Linear Feet 400

Trench Width 36" Max. Trench Bottom Depth 36" Gravel Depth N/A ☒ GRAVITY ☐ PRESSURE

☐ New System ☐ Repair ☐ Expansion System Type I II III IV V VI

System Description: Existing Gravity - 25% Reduction

Repair System Description: Gravity - 50% Reduction

Maintenance Agreement Required ☐ YES ☒ NO

☒ Residence No. Bedrooms 4 ☐ Business No. Persons ☐ Other No. Employees ☐ Slab ☐ Crawl Space ☐ Basement w/plumbing ☐ Basement w/o plumbing


Water Supply ☒ Private ☐ Public ☐ Community

Comments / Conditions: Keep addition (footers/foundation) at least 5ft from Septic System.


Comments / Conditions: Existing Septic System appears to be functioning okay at time of inspection, no problems noticed. Installed "Plastic Chambers" for Drainfield

1:50

INITIAL SITE SKETCH

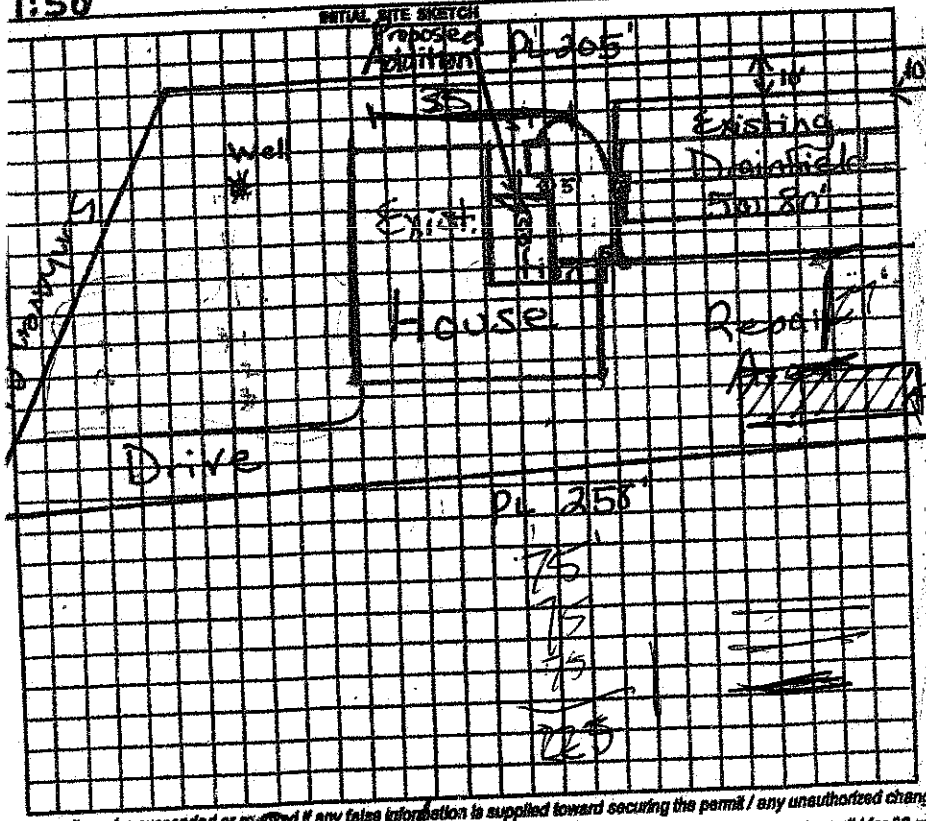

AS BUILT SKETCH

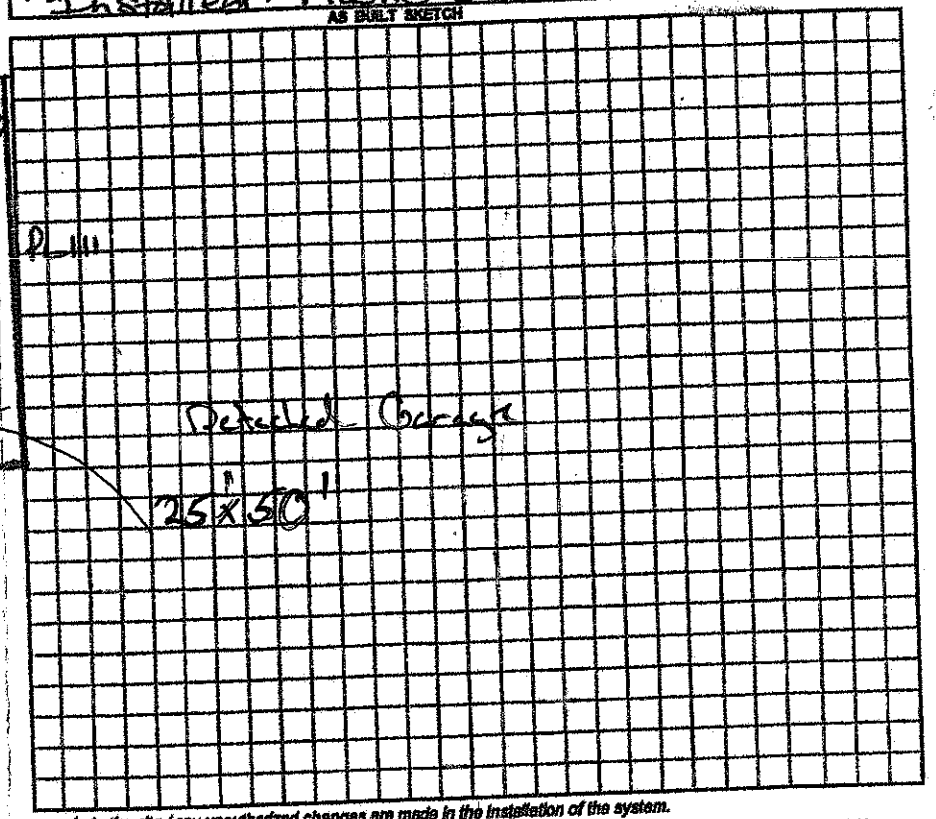

Permit can be suspended or revoked if any false information is supplied toward securing the permit / any unauthorized changes are made to the site / any unauthorized changes are made in the installation of the system.

☐ IMPROVEMENT PERMIT w / plot valid without expiration. ☐ IMPROVEMENT PERMIT w / site plan valid for 60 mos. ☐ AUTHORIZATION TO CONSTRUCT valid for period equal to IMPROVEMENT PERMIT-not to exceed 60 mo.

Owner / Applicant Signature: Dana Friesleger Date 1-30-09

Improvement Permit by: Maiva Hall Date 1/30/09

Authorization to Construct by: Maiva Hall Date 1/30/09

Installed by:

Operation Permit by:

Existing System Inspected by: Maiva Hall RS Date: 1/30/09

CALL LOCATION SERVICE PRIOR TO ANY EXCAVATION.

WHITE COPY Environmental Health YELLOW COPY (Final) Owner / Applicant PINK COPY (Initial) Owner / Applicant