IREDELL COUNTY HEALTH DEPARTMENT

STATESVILLE 704-878-5305 MOORESVILLE 704-664-5281

IMPROVEMENT PERMIT / AUTHORIZATION TO CONSTRUCT / OPERATION PERMIT / EXISTING SYSTEM INSPECTION

PERMIT # 154534 PIN # 4646274087 DATE 1-30-2009

OWNER or APPLICANT J&K Developers / Dana Friesinger PHONE: Business 336 469 2180 Home: 704 6641-2064

OWNER or APPLICANT ADDRESS 3843 Gordon St. Terrell, NC 28682

LOCATION / DIRECTIONS Brawley School Rd TL Williamson TR Sundown Rd TR Shoreview Dr TL Sunhaven Ct. 1st lot on Right

SUBDIVISION Lake Vista BLOCK / SECTION LOT # 11 LOT AREA .72Acre DESIGN FLOW 480gpd L.T.A.R. .3

Existing Septic

Septic Tank 1000 Gallons: STB Date

Pump Tank Gallons: P T Date

Pump Make Model Serial #

Nitrification Field No Fields 1 No Lines 5 Linear Feet 400

Trench Width 36" Max. Trench Bottom Depth 36" Gravel Depth N/A

☐ New System ☐ Repair ☐ Expansion System Type I II III IV V VI

System Description: Existing Gravity - 25% Reduction

Repair System Description: Gravity - 50% Reduction

Maintenance Agreement Required ☐ YES ☒ NO

☒ GRAVITY ☐ PRESSURE

☒ Residence No. Bedrooms 4

☐ Business No. Persons

☐ Other No. Employees

☐ Slab ☐ Crawl Space

☐ Basement w/plumbing ☐ Basement w/o plumbing


Water Supply: ☒ Private ☐ Public ☐ Community

Comments / Conditions Keep addition (footers/foundation) at least 5ft from Septic System.


1:50

Comments / Conditions Existing Septic System appears to be functioning okay at time of inspection, no problems noticed. Installed "Plastic Chambers" for Drainfield

INITIAL SITE SKETCH

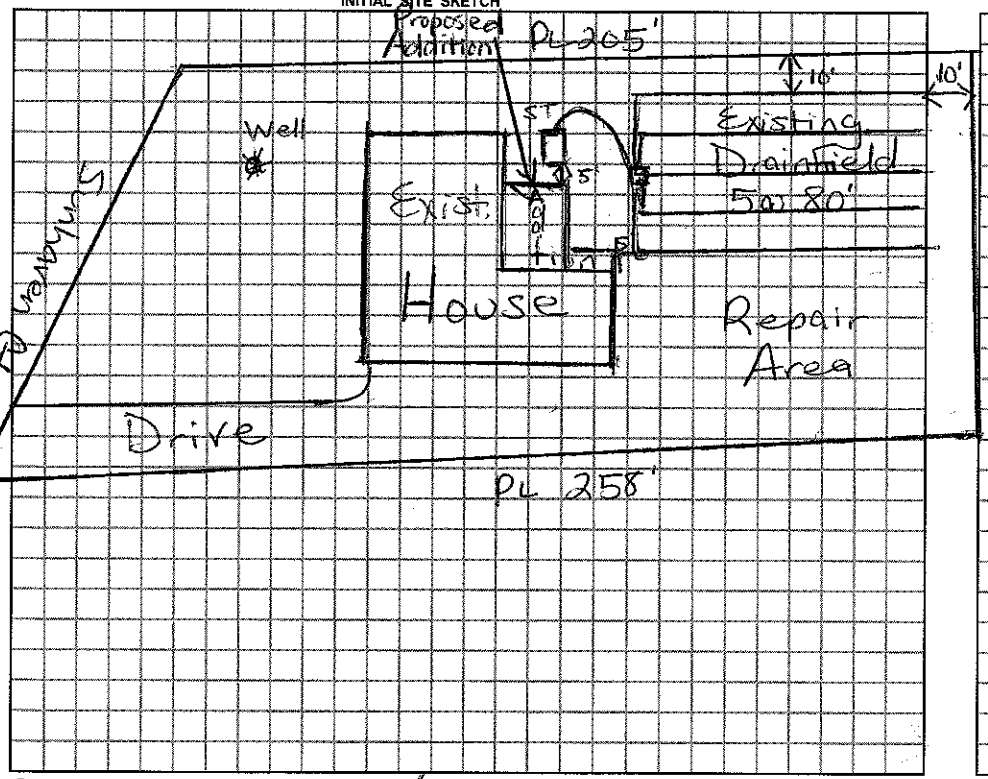

AS BUILT SKETCH

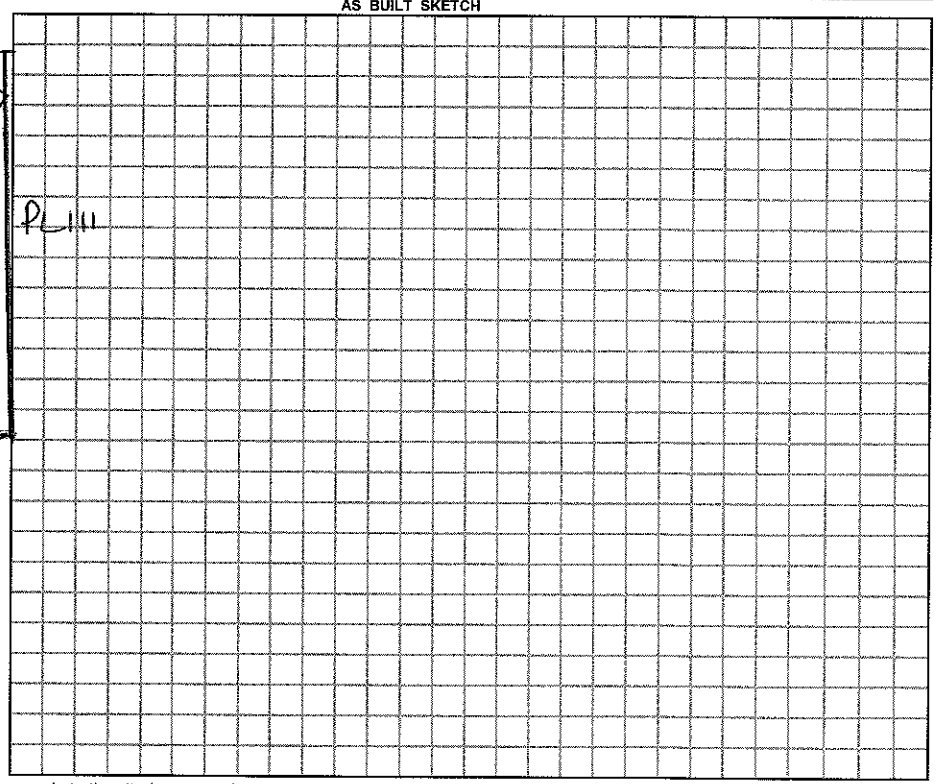

Permit can be suspended or revoked if any false information is supplied toward securing the permit / any unauthorized changes are made to the site / any unauthorized changes are made in the installation of the system.

☐ *IMPROVEMENT PERMIT w / plat valid without expiration.* ☐ *IMPROVEMENT PERMIT w / site plan valid for 60 mos.* ☐ *AUTHORIZATION TO CONSTRUCT valid for period equal to IMPROVEMENT PERMIT-not to exceed 60 mo.*

Owner / Applicant Signature: Dana Friesinger Date 1-30-09

Improvement Permit by: Maria H. Colson RS Date 1/30/09

Authorization to Construct by: Maria H. Colson RS Date 1/30/09

YOU SHOULD CONTACT A LOCATOR SERVICE PRIOR TO ANY EXCAVATION.

Installed by:

Operation Permit by: Date:

Existing System Inspected by: Maria H. Colson RS Date: 1/30/09

WHITE COPY Environmental Health YELLOW COPY (Final) Owner / Applicant PINK COPY (Initial) Owner / Applicant