IREDELL COUNTY HEALTH DEPARTMENT

STATESVILLE 704-878-5305 MOORESVILLE 704-664-5281

IMPROVEMENT PERMIT / AUTHORIZATION TO CONSTRUCT / OPERATION PERMIT / EXISTING SYSTEM INSPECTION

PERMIT # 154534 PIN # 4646274087 DATE 1-30-2009

OWNER or APPLICANT J&K Developers / Dana Friesinger PHONE: Business 336 469 2180 Home: 704 664-2064

OWNER or APPLICANT ADDRESS 3843 Gordon St. Tenstell, NC 28682

LOCATION / DIRECTIONS Brawley School Rd TL Williamson TR Sundown Rd TR Shoreview Dr TL Sunhaven Ct. 1st lot on Right

SUBDIVISION Lake Vista BLOCK / SECTION LOT # 11 LOT AREA .72Acre DESIGN FLOW 480gpd L.T.A.R. .3

Existing Septic

Septic Tank 1000 Gallons: STB Date

Pump Tank Gallons: PT Date

Pump Make Model Serial #

Nitrification Field No Fields 1 No Lines 5 Linear Feet 400

Trench Width 36" Max. Trench Bottom Depth 36" Gravel Depth N/A ☒ GRAVITY ☐ PRESSURE

☐ New System ☐ Repair ☐ Expansion System Type I II III IV V VI

System Description: Existing Gravity - 25% Reduction

Repair System Description: Gravity - 50% Reduction

Maintenance Agreement Required ☐ YES ☒ NO

☒ Residence No. Bedrooms 4 ☐ Business No. Persons ☐ Other No. Employees ☐ Slab ☐ Crawl Space ☐ Basement w/plumbing ☐ Basement w/o plumbing


Water Supply ☒ Private ☐ Public ☐ Community

Comments / Conditions Keep addition (footers/foundation) at least 5ft from Septic System.

Comments / Conditions Existing Septic System appears to be functioning okay at time of inspection, no problems noticed. Installed "Plastic Chambers" for Drainfield

1:50

INITIAL SITE SKETCH

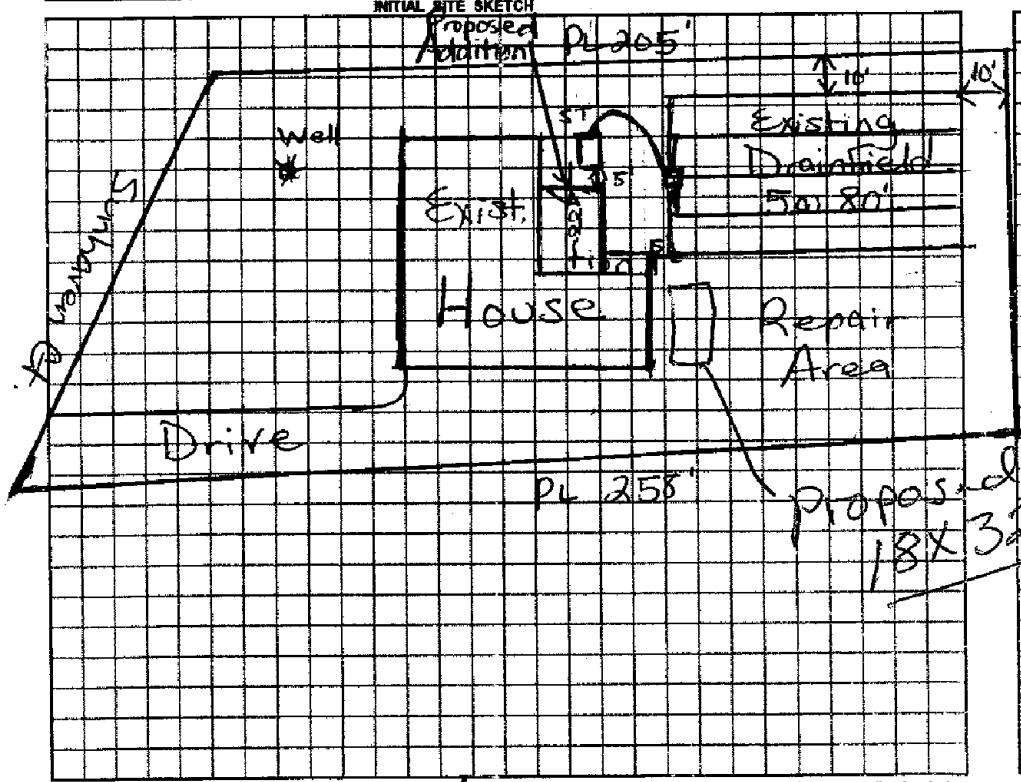

AS BUILT SKETCH

Permit can be suspended or revoked if any false information is supplied toward securing the permit / any unauthorized changes are made to the site / any unauthorized changes are made in the installation of the system.

☐ IMPROVEMENT PERMIT w / plat valid without expiration. ☐ IMPROVEMENT PERMIT w / site plan valid for 60 mos. ☐ AUTHORIZATION TO CONSTRUCT valid for period equal to IMPROVEMENT PERMIT-not to exceed 60 mo.

Owner / Applicant Signature: Dana Friesinger Date 1-30-09

Improvement Permit by: Maria H. Dotson RS Date 1/30/09

Authorization to Construct by: Maria H. Dotson RS Date 1/30/09

YOU SHOULD CONTACT A LOCATOR SERVICE PRIOR TO ANY EXCAVATION.

Installed by:

Operation Permit by: Date:

Existing System Inspected by: Maria H. Dotson RS Date: 1/30/09

WHITE COPY Environmental Health YELLOW COPY (Final) Owner / Applicant PINK COPY (Initial) Owner / Applicant