IREDELL COUNTY HEALTH DEPARTMENT

STATESVILLE 704-878-5305 MOORESVILLE 704-664-5281

IMPROVEMENT PERMIT / AUTHORIZATION TO CONSTRUCT / OPERATION PERMIT / EXISTING SYSTEM INSPECTION

PERMIT # 154534 PIN # 4646274087 DATE 11-8-2010

OWNER or APPLICANT Ross Friesinger PHONE: Business 7046645725 Home: 704 664-2064

OWNER or APPLICANT ADDRESS 108 Sunhaven Ln Mooresville, NC 28117

LOCATION / DIRECTIONS Brawley School Rd TL Williamson TR Sundown TR Shoreview TL Sunhaven 1st on Rt.

SUBDIVISION Lake Vista (Lot #11) BLOCK / SECTION LOT # 11 LOT AREA .72AC DESIGN FLOW 360gpd L.T.A.R. .3

Septic Tank 1000 Gallons: STB Date

Pump Tank Gallons: P T Date

Pump Make Model Serial #

Nitrification Field No Fields 1 No Lines 5 Linear Feet 400'

Trench Width 36" Max. Trench Bottom Depth 36" Gravel Depth N/A

☐ New System ☐ Repair ☐ Expansion System Type I II III IV V VI

System Description: Exist Gravity-25% Reduction

Repair System Description: Grav/Pump 25-50% Reduction

Maintenance Agreement Required ☐ YES ☐ NO

☒ GRAVITY ☐ PRESSURE

☒ Residence No. Bedrooms 3

☐ Business No. Persons

☐ Other No. Employees

☐ Slab ☐ Crawl Space

☐ Basement w/plumbing ☐ Basement w/o plumbing

Water Supply: ☒ Private ☐ Public ☐ Community


Exist

Comments / Conditions: Existing Septic System Appears to be Functioning okay at time of inspection.

* Must obtain a pool permit prior to Construction of pool.

Comments / Conditions: Septic System originally permitted for 4 Bedrooms but Changed to 3 Bedrooms to accomodate area for "Inground" Swimming pool.

INITIAL SITE SKETCH

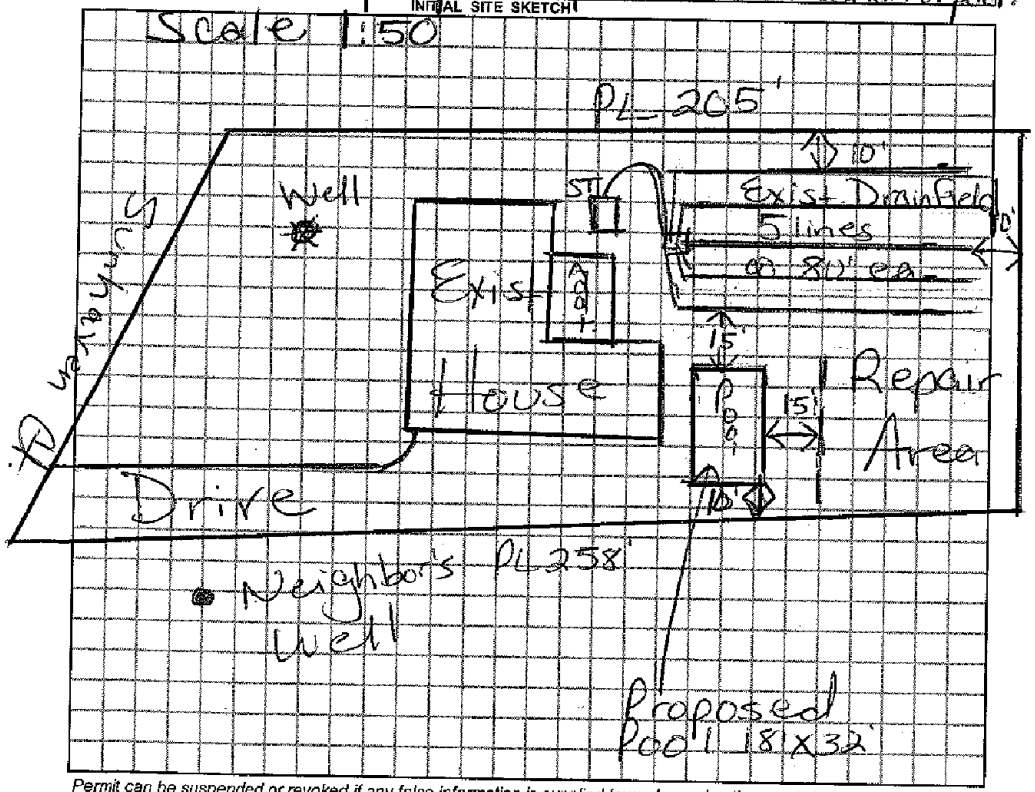

AS BUILT SKETCH

Any future pool must be 15ft from any part of Septic System including "Repair Area".

PL 11'

Permit can be suspended or revoked if any false information is supplied toward securing the permit / any unauthorized changes are made to the site / any unauthorized changes are made in the installation of the system.

☐ IMPROVEMENT PERMIT w/ plat valid without expiration. ☐ IMPROVEMENT PERMIT w / site plan valid for 60 mos. ☐ AUTHORIZATION TO CONSTRUCT valid for period equal to IMPROVEMENT PERMIT-not to exceed 60 mo.

Owner / Applicant Signature: Ross Friesinger Date 11-8-10

Improvement Permit by: Date

Authorization to Construct by: Date

YOU SHOULD CONTACT A LOCATOR SERVICE PRIOR TO ANY EXCAVATION.

Installed by: Brad Russell 1/7/97

Operation Permit by: Date:

Existing System Inspected by: James H. Dotson RS Date: 11/8/2010

WHITE COPY Environmental Health YELLOW COPY (Final) Owner / Applicant PINK COPY (Initial) Owner / Applicant