IREDELL COUNTY HEALTH DEPARTMENT

STATESVILLE 704-878-5305 MOORESVILLE 704-664-5281

IMPROVEMENT PERMIT / CERTIFICATE OF COMPLETION / OPERATION PERMIT / EXISTING SYSTEM INSPECTION

PROPERTY DESCRIPTION NO. 20669 DATE 6/5/95 TAX MAP NO. 2K B 27 Pt of. Watershed: [X] Yes [ ] No

OWNER OR CONTRACTOR Genesis Developers LTD. PHONE: Business 704-478-2952 Home

ADDRESS PO Box 44 Sherrills Ford NC. 28673

LOCATION Sundown Rd TR on Shoreview Dr. TL on Sunbeam Ct 1st lot on (R)

SUBDIVISION LAKE VISTA BLOCK / SECTION 1 LOT 11 LOT AREA .72 Ac SITE CLASS. P DESIGN FLOW 480 L.T.A.R. .3

Septic Tank: 1000 Gallons; STB 797 Date 10/16/96

Pump Tank: Gallons; PT Date

Pump Make: Model Serial No.

Nitrification Field: No Fields 1 Square Feet 1600 Linear Feet *400 (533)

No Lines 5 Trench Width 36" Max Trench Bottom Depth 36" Gravel Depth N/A

[X] New System [ ] Repair System Type: I, II, (III) IV, V, VI

System Description: GRAV INFILTRATOR

Repair System Description: GRAV PANEL

Maintenance Agreement Required: [ ] Yes [ ] No

[X] House/Mod. Home [ ] Mobile Home [ ] Business [ ] Other

No. Bedrooms 4 No. Bathrooms 3 No. Employees

[ ] Slab [X] Crawl Space [ ] Basement w/plumbing [ ] Basement wo/plumbing


Water Supply: [X] Individual [ ] Community [ ] Public

Comments: * 25% reduction for Infiltrator

1:50 SCREEN PORCH WITHIN HOUSE

Comments: EVERGLADE

INITIAL SITE SKETCH

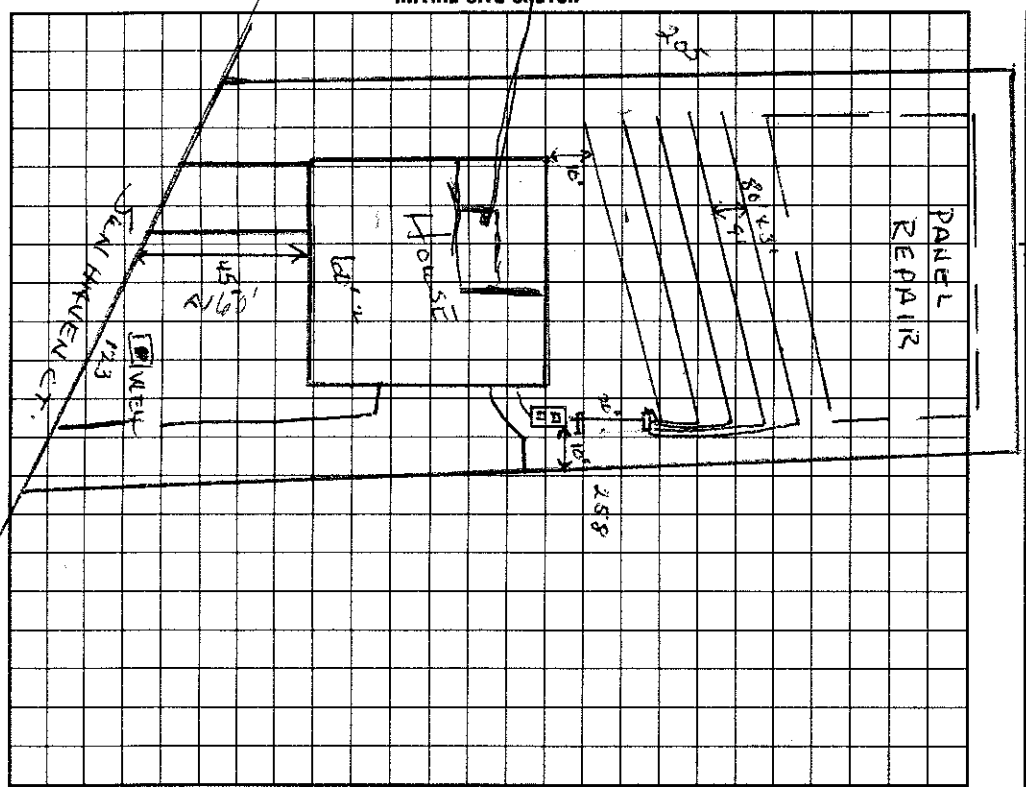

AS BUILT SKETCH

I understand that this permit can be suspended or revoked if any false information is supplied toward securing the permit/any unauthorized changes are made to the site/any unauthorized changes are made in the installation of the system. Improvement Permit is valid for 60 months from date of issuance.

Signed:

Improvement Permit by: Wesley Sparks R.S. date 6/5/95

Existing System Inspection by: date

Installed by: Brad Russell

Certificate of Completion by: date

Operation Permit by: Wesley Sparks R.S. date 1/7/97

HEALTH DEPT. COPY: WHITE INSPECTION COPY (FINAL): GREEN OWNER COPY (FINAL): YELLOW INSPECTION COPY (INITIAL): PINK OWNER COPY (INITIAL): GOLD