IREDELL COUNTY HEALTH DEPARTMENT

STATESVILLE 704-878-5305 MOORESVILLE 704-664-5281

IMPROVEMENT PERMIT / CERTIFICATE OF COMPLETION / OPERATION PERMIT / EXISTING SYSTEM INSPECTION

PROPERTY DESCRIPTION NO. 20664 DATE 6/5/95 TAX MAP NO. Pt of 2K B 27 Watershed: [X] Yes [ ] No

OWNER OR CONTRACTOR Genesis Developers LTD. PHONE: Business 704- 478 - 2952 ~~Home~~ 464-27-4268

ADDRESS PO Box 44 Sherrills Ford, NC. 28673

LOCATION Sundown Rd. TR Shoreview Drive, 2nd lot on (L) past Sunbrown CT.

SUBDIVISION LAKE VISTA BLOCK / SECTION 1 LOT 9 LOT AREA .64 AC SITE CLASS. P DESIGN FLOW 480 L.T.A.R. .3

Septic Tank: 1000 Gallons; STB 794 Date 3/27/96

Pump Tank: _____ Gallons; PT _____ Date _____

Pump Make: _____ Model _____ Serial No. _____

Nitrification Field: No Fields 1 Square Feet 1600 Linear Feet ~~400~~ (533)

No Lines 5 Trench Width 36" Max Trench Bottom Depth 36" Gravel Depth N/A

[X] New System [ ] Repair System Type: I, II, [III], IV, V, VI

System Description: GRAV INFILTRATOR

Repair System Description: SAME

Maintenance Agreement Required: [ ] Yes [X] No

[X] House/Mod. Home No. Bedrooms 4

[ ] Mobile Home No. Bathrooms 3

[ ] Business No. Employees _____

[ ] Other _____


[ ] Slab [X] Crawl Space [ ] Basement w/plumbing [ ] Basement wo/plumbing

Water Supply:
[X] Individual
[ ] Community
[ ] Public

Comments: * 25% reduction for infiltrator use

Comments:

INITIAL SITE SKETCH

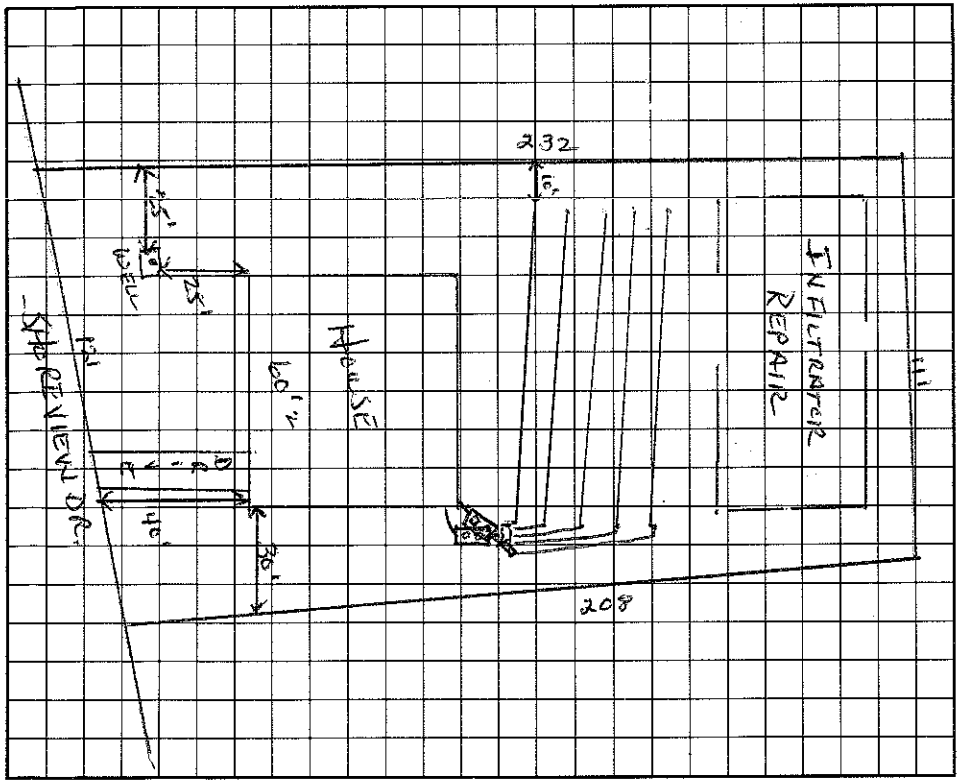

AS BUILT SKETCH

I understand that this permit can be suspended or revoked if any false information is supplied toward securing the permit/any unauthorized changes are made to the site/any unauthorized changes are made in the installation of the system. Improvement Permit is valid for 60 months from date of issuance.

Signed: _____

Improvement Permit by: Wesley Sparks RS. date 6/5/95

Existing System Inspection by: _____ date _____

Installed by: Clon Horne Grading

Certificate of Completion by: _____ date _____

Operation Permit by: Wesley Sparks RS date 6/14/96

HEALTH DEPT. COPY: WHITE INSPECTION COPY (FINAL): GREEN OWNER COPY (FINAL): YELLOW INSPECTION COPY (INITIAL): PINK OWNER COPY (INITIAL): GOLD