IREDELL COUNTY HEALTH DEPARTMENT

Authorization to Construct (9:30 - 10:00)

STATESVILLE 704-878-5305 MOORESVILLE 704-664-5281

IMPROVEMENT PERMIT / ~~CERTIFICATE OF COMPLETION~~ / OPERATION PERMIT / EXISTING SYSTEM INSPECTION

PROPERTY DESCRIPTION NO. ~~Rpta~~ 20665 DATE 4/16/97 TAX MAP NO. 2K B 27 Pt of. Watershed: X Yes ☐ No

OWNER OR CONTRACTOR C W Brewer PHONE: Business ~~Home~~ ~~4635802352~~

ADDRESS PO Box 619 Mt Mourne, NC. 28123 / 464-274400

LOCATION Sundown Rd TR Shoreview Dr. Lies (R) on (L) at start of cul de sac

SUBDIVISION Lake Vista BLOCK / SECTION 1 LOT 8 LOT AREA ~ .5 Ac SITE CLASS. PS DESIGN FLOW 360 L.T.A.R. ~~.35~~

Septic Tank: 1000 Gallons; STB 794 Date 2/22/97

Pump Tank: _____ Gallons; PT _____ Date _____

Pump Make: _____ Model _____ Serial No. _____

Nitrification Field: No Fields 1 Square Feet ~~540~~ Linear Feet ~~270~~

No Lines 3 Trench Width 24" Max Trench Bottom Depth 36" Gravel Depth SAND

X New System ☐ Repair System Type: I, II, (III), IV, V, VI

System Description: GRAV - 16" PPBS

Repair System Description: SAME

Maintenance Agreement Required: ☐ Yes ☐ No

X House/Mod. Home No. Bedrooms 3

☐ Mobile Home No. Bathrooms 2

☐ Business No. Employees ____

☐ Other _____


☐ Slab ☐ Crawl Space X Basement w/plumbing ☐ Basement wo/plumbing

Water Supply: X Individual ☐ Community ☐ Public


Comments:

Comments: CUL DE SAC

INITIAL SITE SKETCH

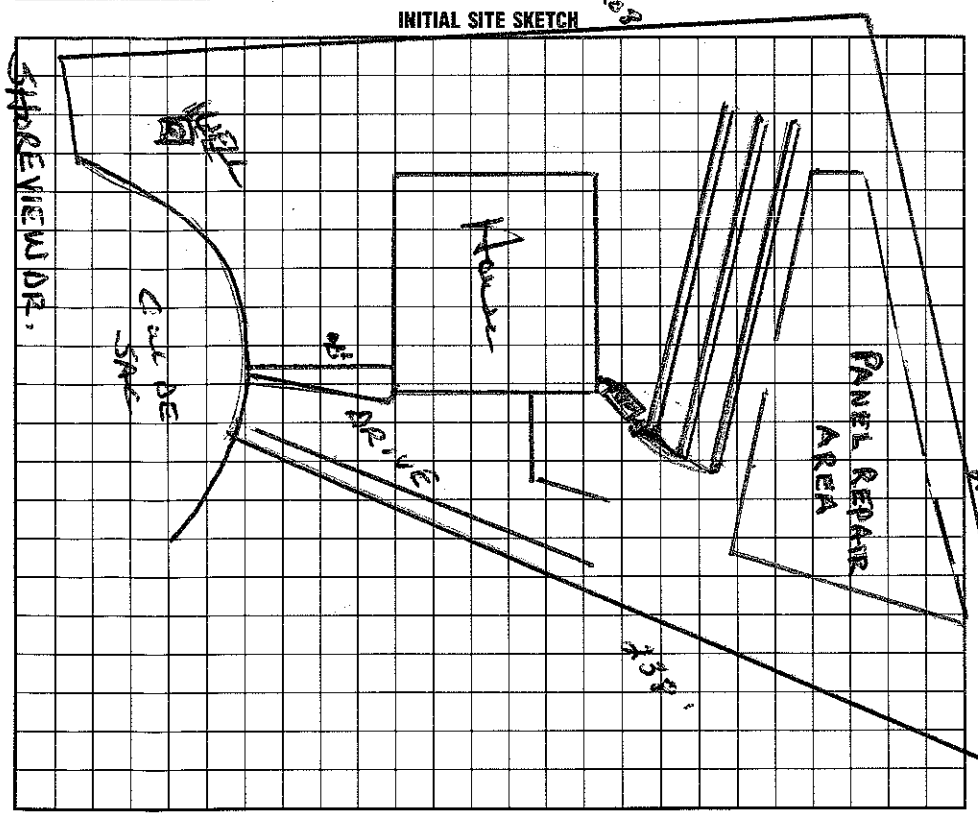

AS BUILT SKETCH

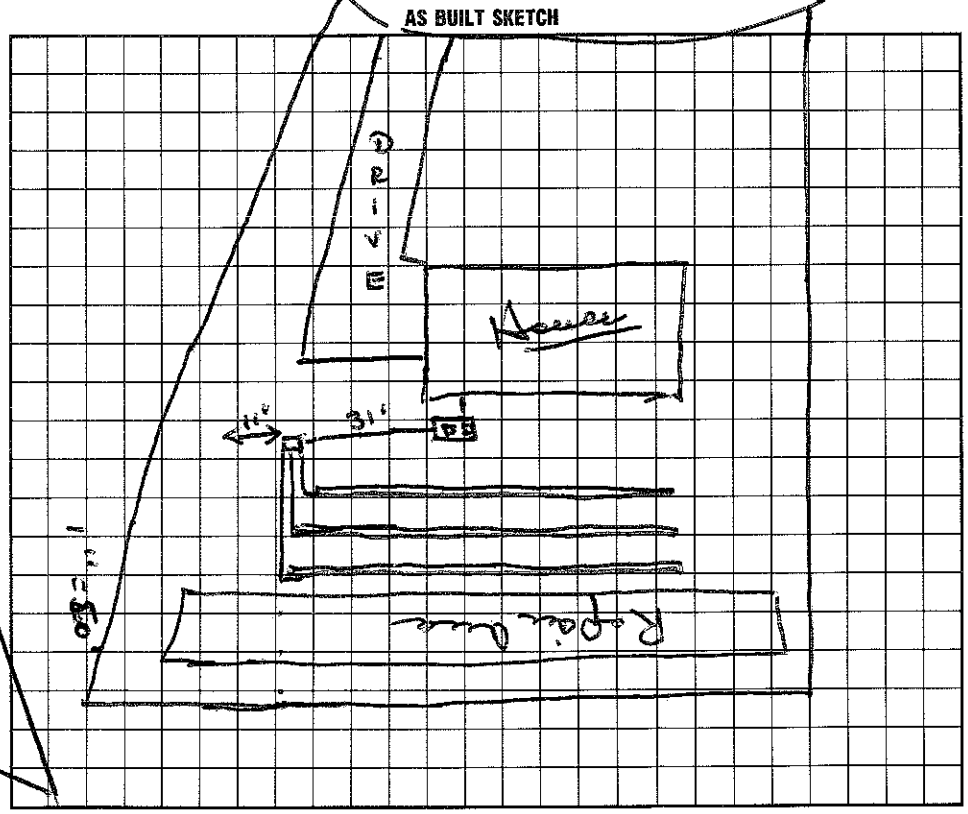

I understand that this permit can be suspended or revoked if any false information is supplied toward securing the permit/any unauthorized changes are made to the site/any unauthorized changes are made in the installation of the system. Improvement Permit is valid for 60 months from date of issuance.

Signed: X Irene Yarrow

Improvement Permit by: Wesley Sparks R.S. date 4/16/97

Existing System Inspection by: Wesley Sparks R.S. date 4/16/97

Installed by: Ken Painter

Certificate of Completion by: Wesley Sparks R.S. date 5/21/97

Operation Permit by: Wesley Sparks R.S. date 5/21/97

HEALTH DEPT. COPY: WHITE INSPECTION COPY (FINAL): GREEN OWNER COPY (FINAL): YELLOW INSPECTION COPY (INITIAL): PINK OWNER COPY (INITIAL): GOLD