IREDELL COUNTY HEALTH DEPARTMENT

STATESVILLE 704-878-5305 MOORESVILLE 704-664-5281

IMPROVEMENT PERMIT / CERTIFICATE OF COMPLETION / OPERATION PERMIT / EXISTING SYSTEM INSPECTION

PROPERTY DESCRIPTION NO. 20668 DATE 6/5/95 TAX MAP NO. 4646 of 2K B 27 Watershed: [X] Yes [ ] No

OWNER OR CONTRACTOR Genesis Developers LTD. PHONE: Business 704-478-2952 ~~Home~~ 4646-27-5117

ADDRESS PO Box 44 Sherrills Ford, NC. 28673

LOCATION Sundown Rd. TR Shoreview Dr. on (L) in forks of Sundown and Shoreview Dr.

SUBDIVISION LAKE VISTA BLOCK / SECTION 1 LOT 10 LOT AREA .83 Ac SITE CLASS P DESIGN FLOW 480 L.T.A.R. .3

Septic Tank: 1000 Gallons; STB 794 Date 12/7/94
Pump Tank: _____ Gallons; PT _____ Date _____
Pump Make: _____ Model _____ Serial No. _____
Nitrification Field: No Fields 1 Square Feet 1600 Linear Feet ~~400~~ 533
No Lines 5 Trench Width 36" Max Trench Bottom Depth 36" Gravel Depth N/A

[X] New System [ ] Repair System Type: I, II, (III) IV, V, VI
System Description: GRAV - INFILTRATOR
Repair System Description: GRAV - PANEL
Maintenance Agreement Required: [ ] Yes [X] No


[X] House/Mod. Home No. Bedrooms 4
[ ] Mobile Home No. Bathrooms 3
[ ] Business No. Employees _____
[ ] Other _____
[ ] Slab [X] Crawl Space [ ] Basement w/plumbing [ ] Basement wo/plumbing

Water Supply:
[X] Individual
[ ] Community
[ ] Public

Comments: ~~X~~ 25% reduction for infiltrator use

Comments:

INITIAL SITE SKETCH

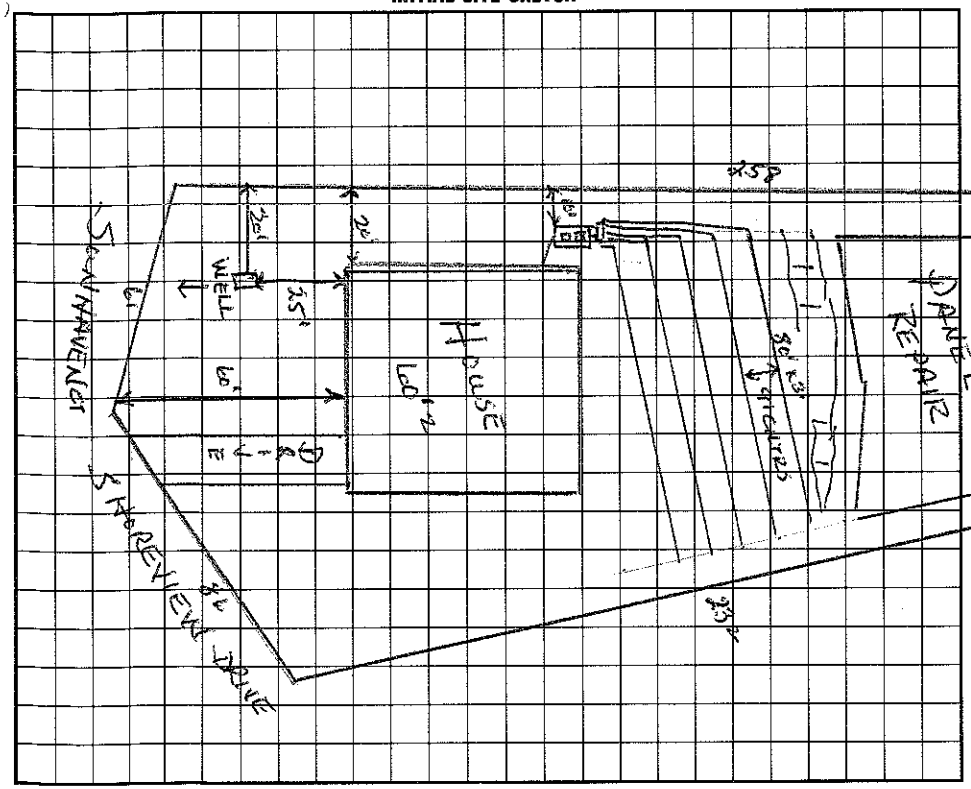

AS BUILT SKETCH

I understand that this permit can be suspended or revoked if any false information is supplied toward securing the permit/any unauthorized changes are made to the site/any unauthorized changes are made in the installation of the system. Improvement Permit is valid for 60 months from date of issuance.

Signed: _____

Improvement Permit by: Wesley Sparks R.S. date 6/5/95

Inspection by: _____ date _____

Installed by: Iron Horse Grading

Certificate of Completion by: Wesley Sparks R.S. date 4/15/97

Operation Permit by: Wesley Sparks R.S. date 4/15/97

PINK DEPT. COPY: WHITE INSPECTION COPY (FINAL): GREEN OWNER COPY (FINAL): YELLOW INSPECTION COPY (INITIAL): PINK OWNER COPY (INITIAL): GOLD