# IREDELL COUNTY HEALTH DEPARTMENT

STATESVILLE 704-878-5305 MOORESVILLE 704-664-5281

## IMPROVEMENT PERMIT / CERTIFICATE OF COMPLETION / OPERATION PERMIT / EXISTING SYSTEM INSPECTION

PROPERTY DESCRIPTION NO. 20658 DATE 5/22/95 TAX MAP NO. Pt of 2K B 27 4646276367 Watershed: ☐ Yes ☒ No

OWNER OR CONTRACTOR Genesis Developers LTD. PHONE: Business 478-2952 Home

ADDRESS PO Box 44 Shoulds Ford NC. 28673

LOCATION Shoreview Dr. (R) off Sundown Rd. on (R) just before cul de sac

SUBDIVISION LAKE VISTA BLOCK / SECTION 1 LOT 4 LOT AREA .9 AC SITE CLASS. 5 DESIGN FLOW 480 L.T.A.R. .4

Septic Tank: 1000 Gallons; STB 794 Date 3/19/96

Pump Tank: 1000 Gallons; PT 27 Date 3/16/96

Pump Make: ZOELLER Model N98A Serial No. 0002

Nitrification Field: No Fields 1 Square Feet 1200 Linear Feet * 385

No Lines 4 Trench Width 36 Max Trench Bottom Depth 36" Gravel Depth N/A

☒ New System ☐ Repair System Type: I, II, (III), IV, V, VI

System Description: Pressure-Infiltrator

Repair System Description: Pressure Panel

Maintenance Agreement Required: ☒ Yes ☐ No 5 YRS

☒ House/Mod. Home No. Bedrooms 4

☐ Mobile Home No. Bathrooms 3

☐ Business No. Employees

☐ Other


☐ Slab ☒ Crawl Space ☐ Basement w/plumbing ☐ Basement wo/plumbing

Water Supply: ☒ Individual ☐ Community ☐ Public

Comments: * 25% reduction for Infiltrator use
Tight - Be sure before installation
begins

Comments:

INITIAL SITE SKETCH

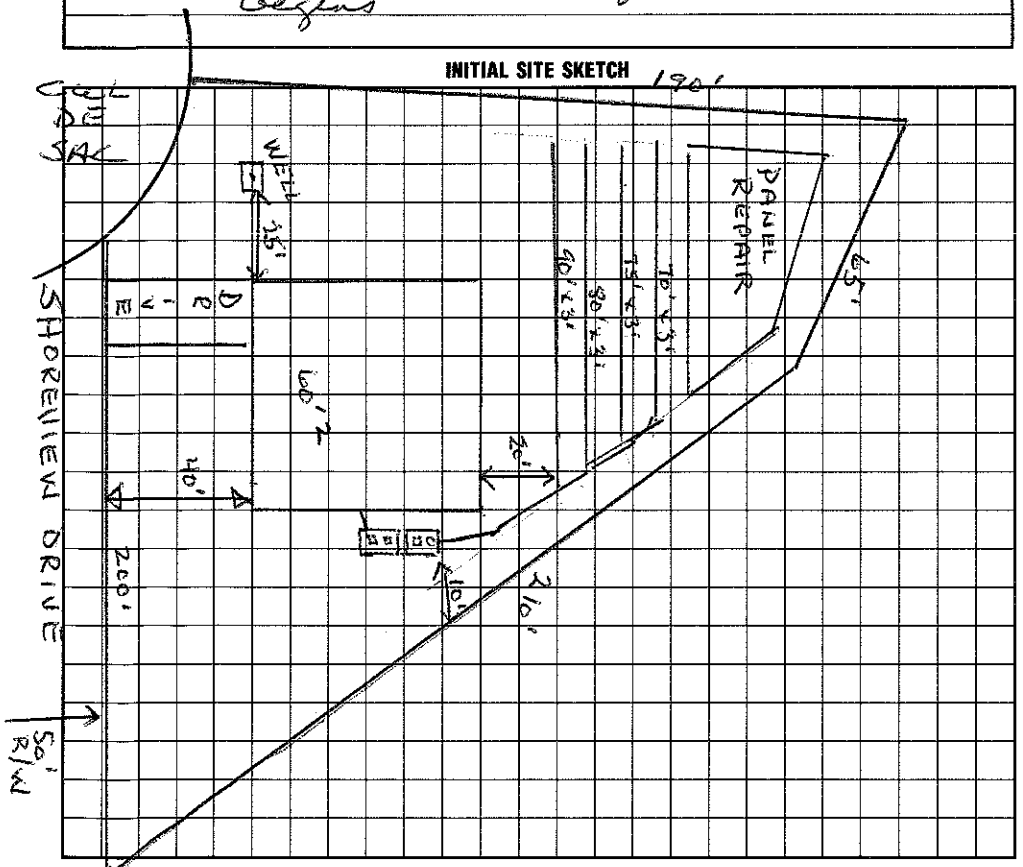


AS BUILT SKETCH

I understand that this permit can be suspended or revoked if any false information is supplied toward securing the permit/any unauthorized changes are made to the site/any unauthorized changes are made in the installation of the sys
Improvement Permit is valid for 60 months from date of issuance.

Signed: [signature]

Improvement Permit by: Wesley Sparks R.S. date 5/22/95

Existing System Inspection by: date

Installed by: Olon House Grading 7/11/96

Certificate of Completion by:

Operation Permit by: Wesley Sparks R.S.

HEALTH DEPT. COPY: WHITE INSPECTION COPY (FINAL): GREEN OWNER COPY (FINAL): YELLOW INSPECTION COPY (INITIAL): PINK