IREDELL COUNTY HEALTH DEPARTMENT

STATESVILLE 704-878-5305 MOORESVILLE 704-664-5281

IMPROVEMENT PERMIT / CERTIFICATE OF COMPLETION / OPERATION PERMIT / EXISTING SYSTEM INSPECTION

PROPERTY DESCRIPTION NO. 20659 DATE 5/22/95 TAX MAP NO. Pt of 2K B 27 Watershed: [X] Yes [ ] No

OWNER OR CONTRACTOR Genesis Developers LTD. PHONE: Business 478-2952 ~~Home 4635-80-2086~~ 4646-27-6582

ADDRESS PO Box 44 Shanks Ford, NC. 28673

LOCATION Lakeshore Drive (R) off Sundown Rd. to culde sac on (R) side

SUBDIVISION LAKE VISTA BLOCK / SECTION 1 LOT 5 LOT AREA ~1.68 AC SITE CLASS. P DESIGN FLOW 480 L.T.A.R. .35

Septic Tank: 1000 Gallons; STB 794 Date 9/5/96
Pump Tank: ____ Gallons; PT ____ Date ____
Pump Make: ____ Model ____ Serial No. ____
Nitrification Field: No Fields 1 Square Feet 1371 Linear Feet (457) 228*
No Lines 4 Trench Width 24" Max Trench Bottom Depth 30" Gravel Depth 6" SAND

[X] New System [ ] Repair System Type: I, II, (III) IV, V, VI
System Description: GRAVITY PANEL 16"
Repair System Description: PRESSURE PANEL
Maintenance Agreement Required: [ ] Yes [X] No


[X] House/Mod. Home No. Bedrooms 4
[ ] Mobile Home No. Bathrooms 3
[ ] Business No. Employees ____
[ ] Other ____
[ ] Slab [X] Crawl Space [ ] Basement w/plumbing [ ] Basement wo/plumbing

Water Supply: [X] Individual [ ] Community [ ] Public

Comments: 50% Reduction for 16" Panel Blocks

Comments:

INITIAL SITE SKETCH

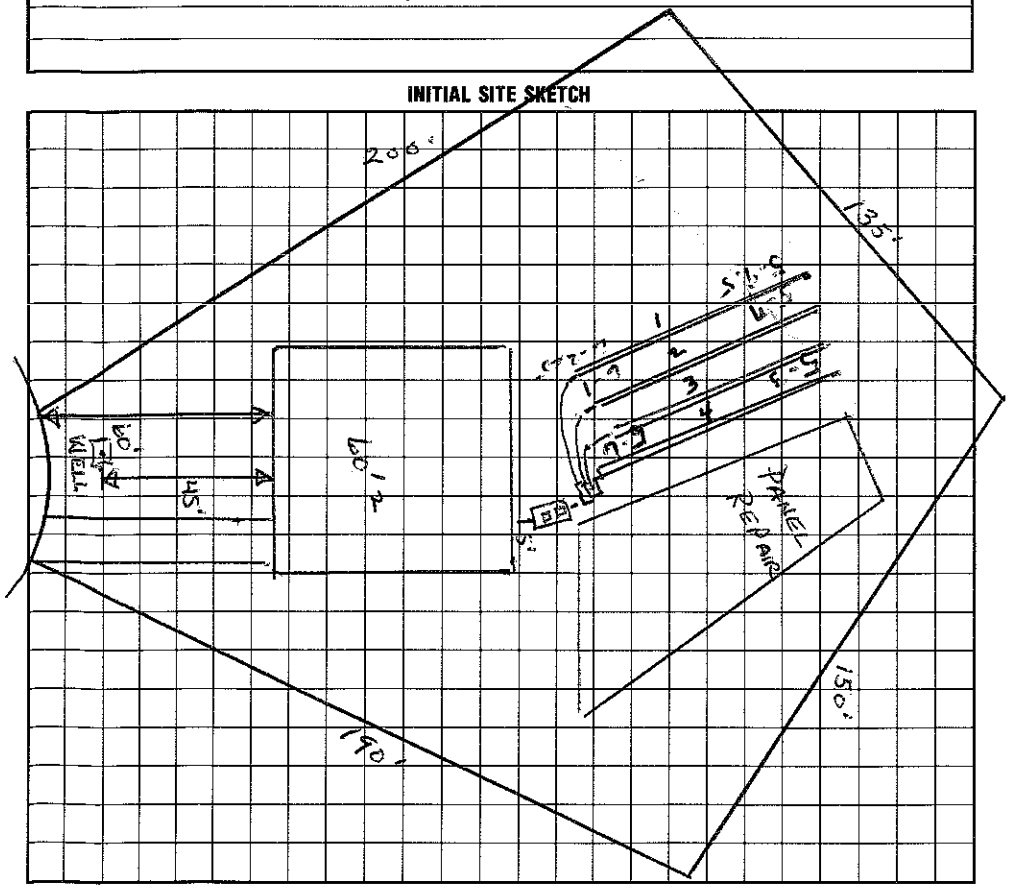

AS BUILT SKETCH

I understand that this permit can be suspended or revoked if any false information is supplied toward securing the permit/any unauthorized changes are made to the site/any unauthorized changes are made in the installation of the system. Improvement Permit is valid for 60 months from date of issuance.

Signed: [signature]

Improvement Permit by: Wesley Sparks RS date 5/22/95

Existing System Inspection by: ____ date ____

Installed by: Dixon House Grading

Certificate of Completion by: ____ date ____

Operation Permit by: Wesley Sparks R.S. date 10/6/96

HEALTH DEPT. COPY: WHITE INSPECTION COPY (FINAL): GREEN OWNER COPY (FINAL): YELLOW INSPECTION COPY (INITIAL): PINK OWNER COPY (INITIAL): GOLD