IREDELL COUNTY HEALTH DEPARTMENT

STATESVILLE 704-878-5305 MOORESVILLE 704-664-5281

IMPROVEMENT PERMIT / AUTHORIZATION TO CONSTRUCT / OPERATION PERMIT / EXISTING SYSTEM INSPECTIO

PERMIT# 106033 PIN# ~~4646204611.9~~ 4646-27-6718 DATE 8/28/02

OWNER OR CONTRACTOR DIENST ENTERPRISES PHONE: Business 304-0123 Home

ADDRESS 19315 W. CATAWBA AVE. CORNELIUS NC

LOCATION WILLIAMSON - TR SUNDOWN - TR SUNDOWN COVE - TL CORONA - ON LT

SUBDIVISION ESTATES @ SUNDOWN BLOCK / SECTION 1 LOT 9 LOT AREA 25006 ft² SITE CLASS. PS DESIGN FLOW 450 GPD L.T.A.R. .36-00/FT

Septic Tank: 1000 Gallons; STB 794 Date 9-30-05

Pump Tank: Gallons; PT Date

Pump Make: Model Serial No.

Nitrification Field: No Fields 1 Square Feet 1200 Linear Feet 400

No Lines 4@100' Trench Width 36" Max Trench Bottom Depth 36" Gravel Depth N/A

☑ New System ☐ Repair System Type: I. II. III. IV. V. VI

System Description: GRAVITY INNOVATIVE

Repair System Description: LP PANEL

Maintenance Agreement Required: ☐ Yes ☑ No

☑ House/Mod. Home No. Bedrooms 4

☐ Mobile Home No. Bathrooms 4

☐ Business No. Employees

☐ Other


☐ Slab ☑ Crawl Space ☐ Basement w/plumbing ☐ Basement wo/plumbing

Water Supply: ☐ Individual ☐ Public ☑ Community

Comments/Conditions: 1) REMOVE & FEATHER OUT TERRACES

Comments/Conditions: Tank Checked 6/14/05

INITIAL SITE SKETCH

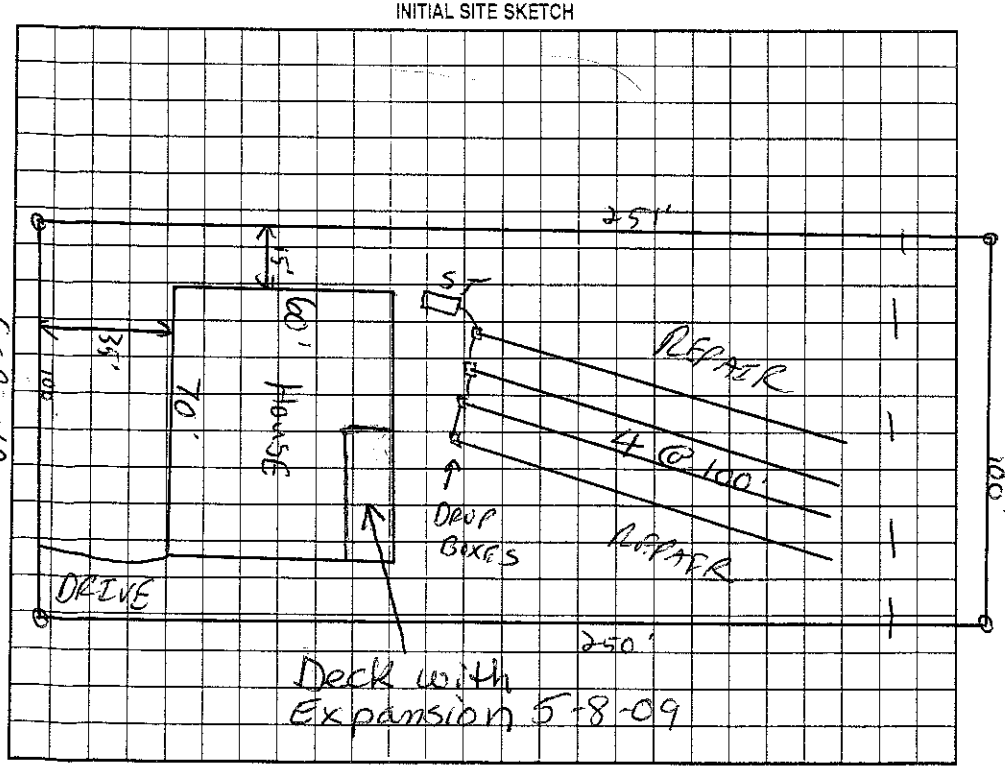

AS BUILT SKETCH

Installed EZ Flow For Drainfield

The proposed / ~~existing~~ deck expansion addition does not appear to impact the existing septic system.

**NOTE:

Andy Melville R.S.

Date: 5-8-09

ICHD-Environmental Health Division

Permit can be suspended or revoked if any false information is supplied toward securing the permit/any unauthorized changes are made to the site/any unauthorized changes are made in the installation of the system. Improvement Permit with plat valid without expiration. Improvement Permit with site plan valid for sixty months. Authorization to Construct is valid for a period equal to that of Improvement Permit – not to exceed sixty months.

Signed: Robert B. Dienst date 9/20/02

Improvement Permit by: C. [illegible] RS date 8/28/02

Authorization to Construct by: [illegible] RS date 3/21/05

Installed by: R&T RS.

Operation Permit by: [illegible] date 6/22/05

Existing System Inspection by: date

HEALTH DEPT. COPY: WHITE OWNER COPY (FINAL): YELLOW OWNER COPY (INITIAL): PINK