IREDELL COUNTY HEALTH DEPARTMENT

STATESVILLE 704-878-5305 MOORESVILLE 704-664-5281

IMPROVEMENT PERMIT / CERTIFICATE OF COMPLETION / OPERATION PERMIT / EXISTING SYSTEM INSPECTION

PROPERTY DESCRIPTION NO. 20683 DATE 4/23/95 TAX MAP NO. 2K B Pt of 27 Watershed: ☐ Yes ☑ No

OWNER OR CONTRACTOR Genesis Developers LTD. PHONE: Business 478-2952 ~~Home~~ 464-27-7024

ADDRESS PO Box 44 Sherrills Ford NC. 28673

LOCATION Sunbeam Rd. TR Shoreview Dr. on (L) at Sunbeam Ct. intersection 360

SUBDIVISION Lake Vista BLOCK / SECTION 1 LOT 20 LOT AREA ~1.03 AC SITE CLASS. P DESIGN FLOW ~~450~~ L.T.A.R. .4

Septic Tank: 1000 Gallons; STB 794 Date 7/14/95

Pump Tank: _____ Gallons; PT _____ Date _____

Pump Make: _____ Model 910 Serial No. 225

Nitrification Field: No Fields 1 Square Feet ~~1200~~ Linear Feet ~~300~~

No Lines 2 Trench Width 36" Max Trench Bottom Depth 36" Gravel Depth N/A

☑ New System ☐ Repair System Type: I, II, III, IV, V, VI

System Description: GRAVITY - Infiltrator

Repair System Description: Same

Maintenance Agreement Required: ☐ Yes ☑ No

☑ House/Mod. Home No. Bedrooms 4

☐ Mobile Home No. Bathrooms 3

☐ Business No. Employees ____

☐ Other _____

☐ Slab ☑ Crawl Space ☐ Basement w/plumbing ☐ Basement wo/plumbing


Water Supply: ☑ Individual ☐ Community ☐ Public

Comments: *.25 Reduction for Infiltrator use

*Authorized change to 225' Infiltrator

Comments:

INITIAL SITE SKETCH

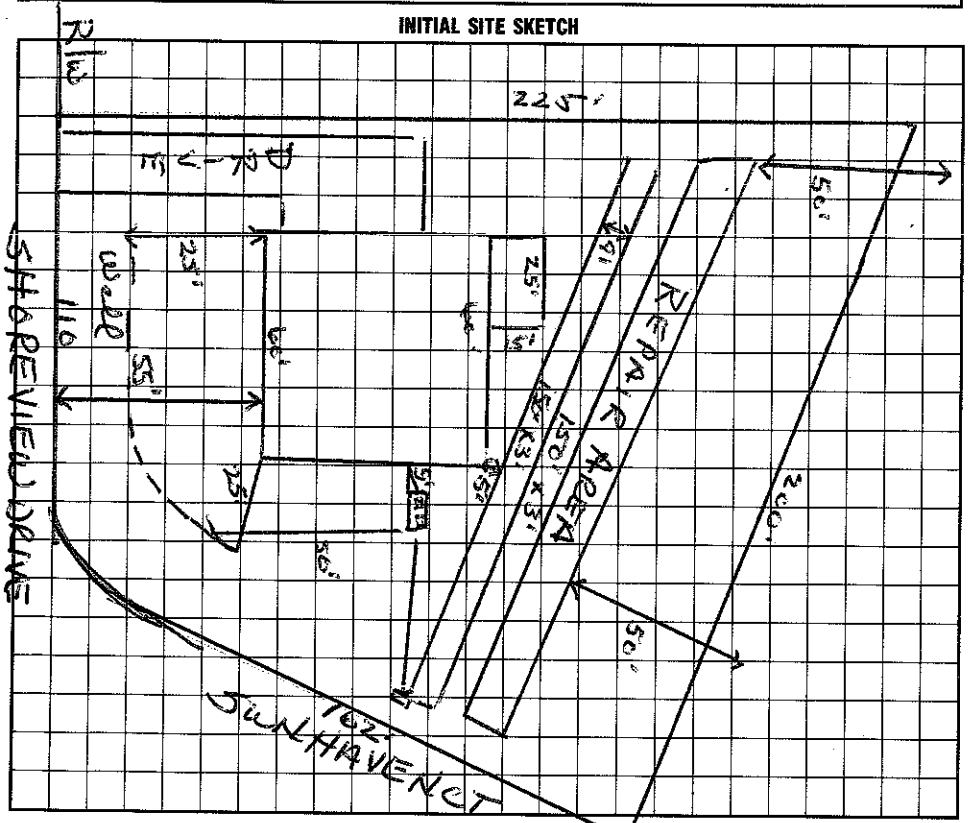

AS BUILT SKETCH

I understand that this permit can be suspended or revoked if any false information is supplied toward securing the permit/any unauthorized changes are made to the site/any unauthorized changes are made in the installation of the system. Improvement Permit is valid for 60 months from date of issuance.

Signed: _____

Improvement Permit by: Wesley Sparks R.S. date 4/27/95

Existing System Inspection by: _____ date _____

Installed by: R L Macleod

Certificate of Completion by: Wesley Sparks R.S. date 9/7/95

Operation Permit by: _____ date _____

HEALTH DEPT. COPY: WHITE INSPECTION COPY (FINAL): GREEN OWNER COPY (FINAL): YELLOW INSPECTION COPY (INITIAL): PINK OWNER COPY (INITIAL): GOLD