IREDELL COUNTY HEALTH DEPARTMENT

STATESVILLE 704-878-5305 MOORESVILLE 704-664-5281

IMPROVEMENT PERMIT / AUTHORIZATION TO CONSTRUCT / OPERATION PERMIT / EXISTING SYSTEM INSPECTION

2:00

PERMIT# 106032 PIN# ~~4646-20-4611.8~~ 4640277725

OWNER OR CONTRACTOR Ryan Homes DATE 11/12/03

ADDRESS 9920 Kincey Ave Huntersville NC 28078 PHONE: Business 704-875-9288 Home

LOCATION Williamson TR Sundown, TR Sundown Covey TL Corona, on Ct

SUBDIVISION Est @ Sundown BLOCK / SECTION LOT 8 LOT AREA 28,337 Ft² SITE CLASS PS DESIGN FLOW 600 L.T.A.R. 0.3

Septic Tank: 1500 Gallons; STB 338 Date 5-7-04

Pump Tank: 1500 Gallons; PT 421 Date 3-30-04

Pump Make: Myers Model ME50-S2 Serial No.

Nitrification Field No. Fields 1 Square Feet 990 Linear Feet 330

No Lines 3 Trench Width 24-36" Max Trench Bottom Depth 36" Gravel Depth

☒ New System ☐ Repair System Type: I, II, III, IV, V, VI

System Description: LP And Block

Repair System Description: Same

Maintenance Agreement Required: ☒ Yes ☐ No

☒ House/Mod. Home ☐ Mobile Home ☐ Business ☐ Other

No. Bedrooms 5 No. Bathrooms No. Employees

☐ Slab ☒ Crawl Space ☐ Basement w/plumbing ☐ Basement wo/plumbing


Water Supply: ☐ Individual ☐ Public ☒ Community

Comments:/Conditions:


Comments:/Conditions: Checked tanks & lines 6/9/04 MD

Checked pressure, elect alarm 6/16/04 MD

INITIAL SITE SKETCH

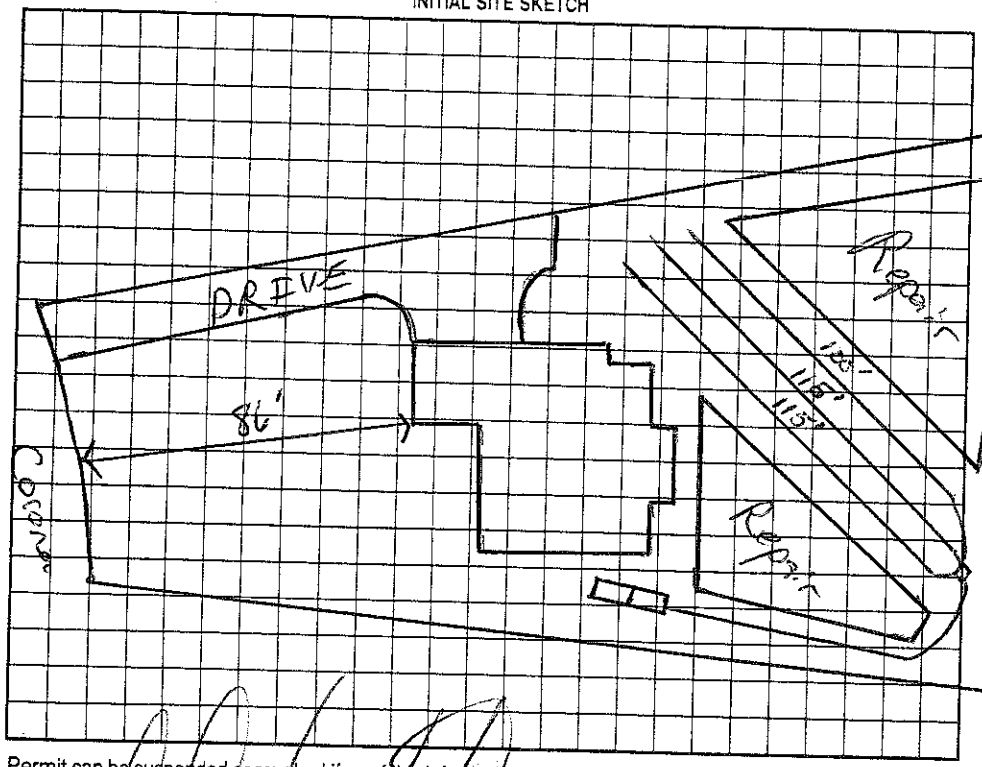

AS BUILT SKETCH

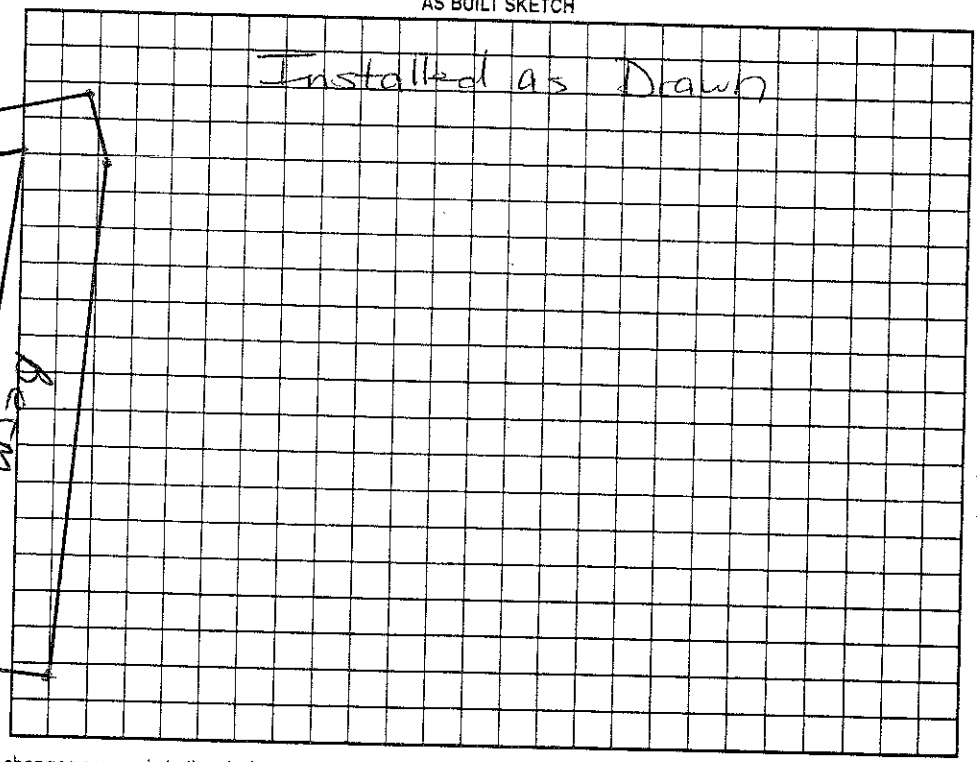

Permit can be suspended or revoked if any false information is supplied toward securing the permit/any unauthorized changes are made to the site/any unauthorized changes are made in the installation of the system. Improvement Permit with plat valid without expiration. Improvement Permit with site plan valid for sixty months. Authorization to Construct is valid for a period equal to that of Improvement Permit – not to exceed sixty months.

Signed: date 11/13/03

Improvement Permit by: RS date 11/12/03

Authorization to Construct by: RS date 11/14/03

Installed by: R & H

Operation Permit by: Maria Hutchinson RS date 6/16/04

Existing System Inspection by: date

HEALTH DEPT. COPY: WHITE OWNER COPY (FINAL): YELLOW OWNER COPY (INITIAL): PINK