4.00

IREDELL COUNTY HEALTH DEPARTMENT

STATESVILLE 704-878-5305 MOORESVILLE 704-664-5281

IMPROVEMENT PERMIT / CERTIFICATE OF COMPLETION / OPERATION PERMIT / EXISTING SYSTEM INSPECTION

PROPERTY DESCRIPTION NO. 20684 DATE 4/23/95 TAX MAP NO. 2K B Pt of 27 Watershed: ☐ Yes ☑ No

OWNER OR CONTRACTOR Genesis Developers LTD (Wm. GRAVES Jr) PHONE: Business 478-2952 ~~Home~~ 464-27-8052

ADDRESS PO Box 44 Sherrills Ford, NC. 28673

LOCATION Sundown Rd. TR Shoreview Dr., 2nd lot on (L)

SUBDIVISION Lake Vista BLOCK / SECTION 1 LOT 21 LOT AREA .64 Ac. SITE CLASS. P DESIGN FLOW ~~480~~ 360 L.T.A.R. .3

Septic Tank: 1000 Gallons; STB 794 Date 4/24/97

Pump Tank: _____ Gallons; PT _____ Date _____

Pump Make: _____ Model 1200 Serial No. _____

Nitrification Field: No Fields 1 Square Feet ~~1600~~ Linear Feet ~~400~~

No Lines 5 Trench Width 36" Max Trench Bottom Depth 34" Gravel Depth N/A

☑ New System ☐ Repair System Type: I, II, (III) IV, V, VI

System Description: GRAV. INFILTRATOR

Repair System Description: SAME

Maintenance Agreement Required: ☐ Yes ☑ No

☑ House/Mod. Home No. Bedrooms ~~3~~ 3

☐ Mobile Home No. Bathrooms 3

☐ Business No. Employees _____

☐ Other _____


☐ Slab ☑ Crawl Space ☐ Basement w/plumbing ☐ Basement wo/plumbing

Water Supply: ☑ Individual ☐ Community ☐ Public

Comments: ~~*~~ .25 reduction for infiltrators use 1/22/97
May use 400 feet of conventional drainfield - HWS

Comments:

INITIAL SITE SKETCH

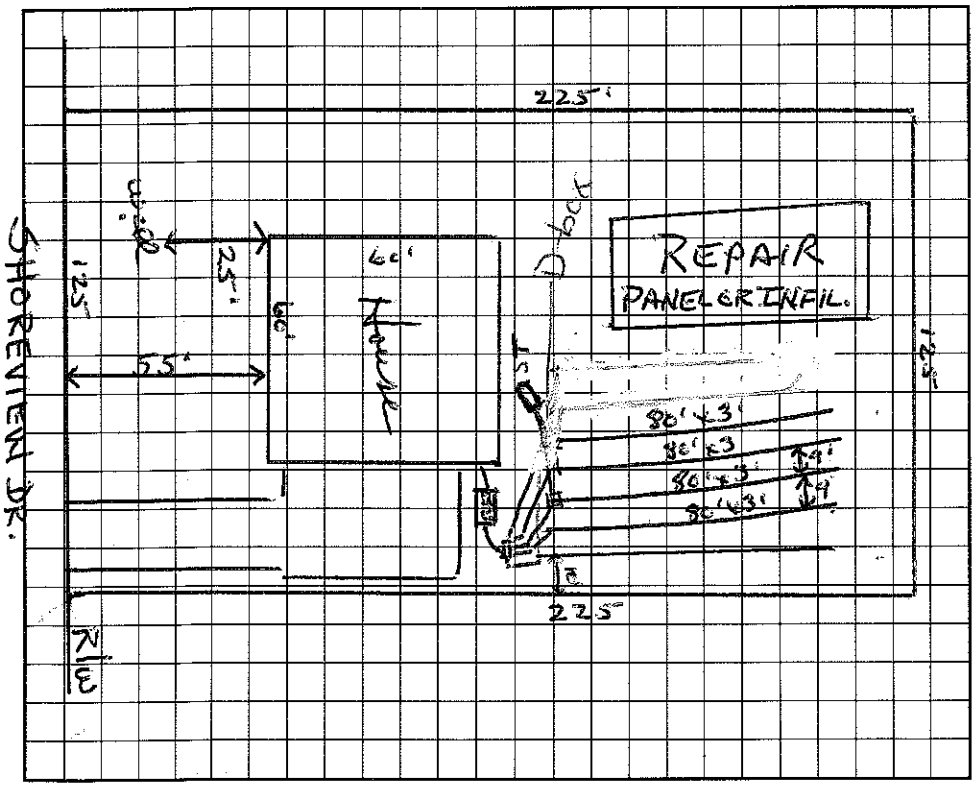

AS BUILT SKETCH

I understand that this permit can be suspended or revoked if any false information is supplied toward securing the permit/any unauthorized changes are made to the site/any unauthorized changes are made in the installation of the system. Improvement Permit is valid for 60 months from date of issuance.

Signed: _____

Improvement Permit by: Wilbur Sparks RS. date 4/27/95

Existing System Inspection by: _____ date _____

Installed by: Curt Dunning

Certificate of Completion by: Maria Dotson date 6/26/97

Operation Permit by: Maria Dotson date 6/26/97

HEALTH DEPT. COPY: WHITE INSPECTION COPY (FINAL): GREEN OWNER COPY (FINAL): YELLOW INSPECTION COPY (INITIAL): PINK OWNER COPY (INITIAL): GOLD