IREDELL COUNTY HEALTH DEPARTMENT

STATESVILLE 704-878-5305 MOORESVILLE 704-664-5281

IMPROVEMENT PERMIT / CERTIFICATE OF COMPLETION / OPERATION PERMIT / EXISTING SYSTEM INSPECTION

PROPERTY DESCRIPTION NO. 20656 DATE 5/15/95 TAX MAP NO. ~~Pt of 2KB27~~ 4646-27-8279 Watershed: ☐ Yes ☒ No

OWNER OR CONTRACTOR Genesis Development (CW BREWER JR) PHONE: Business _____ Home 478-2952

ADDRESS PO Box 44 Shanklin Ford, NC. 28673

LOCATION Shoreview Dr. (R) off Sunset Rd. to 2ND lot on (R)

SUBDIVISION Lake Vista BLOCK / SECTION _____ LOT 12 LOT AREA .64 AC SITE CLASS. P DESIGN FLOW 480 L.T.A.R. .3

Septic Tank: 1000 Gallons; STB 794 Date 1/3/96

Pump Tank: 1000 Gallons; P.T 27 Date 1/3/96

Pump Make: _____ Model _____ Serial No. _____

Nitrification Field: No Fields 1 Square Feet 1200 Linear Feet ~~400~~ 533

No Lines 5 Trench Width 36" Max Trench Bottom Depth 36" Gravel Depth 12"

☑ New System ☐ Repair System Type: I, II, III, IV, V, VI

System Description: Trans - Conventional

Repair System Description: Trans - Pond

Maintenance Agreement Required: ☑ Yes ☐ No

☑ House/Mod. Home No. Bedrooms 4

☐ Mobile Home No. Bathrooms 3

☐ Business No. Employees _____

☐ Other _____


☐ Slab ☒ Crawl Space ☐ Basement w/plumbing ☐ Basement wo/plumbing

Water Supply:
☑ Individual
☐ Community
☐ Public

Comments: Lines to follow old contour lines
9' centers between lines

Comments:

INITIAL SITE SKETCH

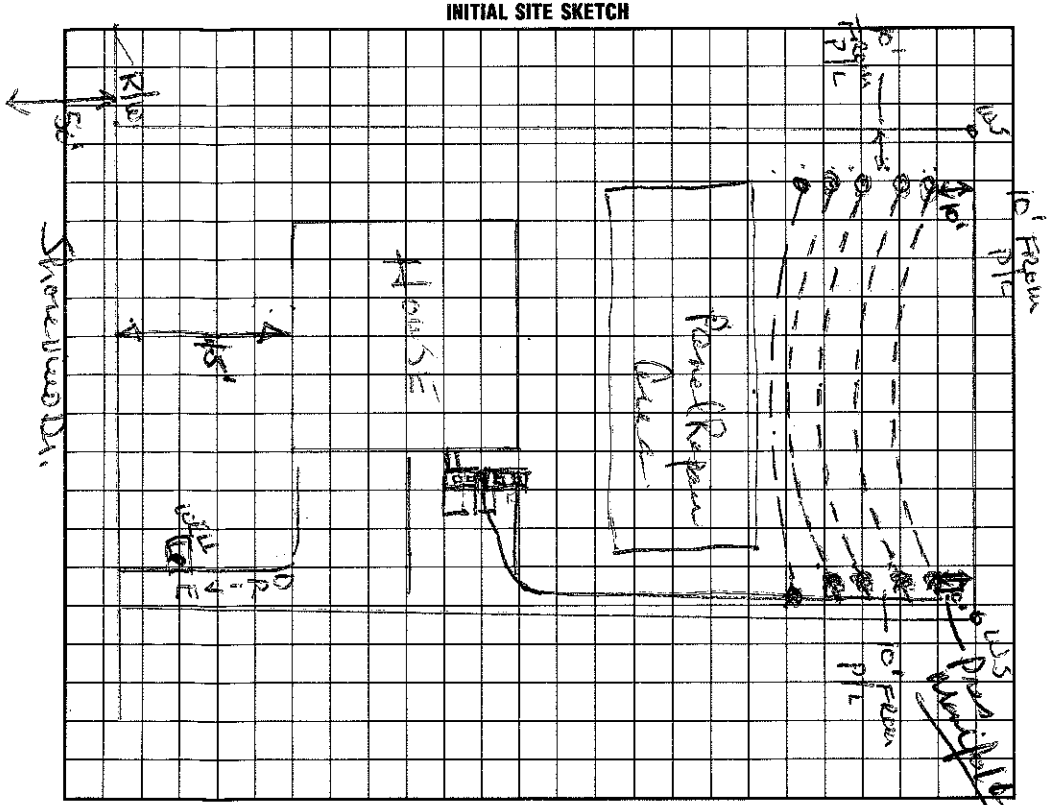

AS BUILT SKETCH

I understand that this permit can be suspended or revoked if any false information is supplied toward securing the permit/any unauthorized changes are made to the site/any unauthorized changes are made in the installation of the system. Improvement Permit is valid for 60 months from date of issuance.

Signed: X _____

Improvement Permit by: Wesley Sparks RS. date 5/15/95

Existing System Inspection by: _____ date _____

Installed by: Ken Painter - Owner Home

Certificate of Completion by: Wesley Sparks RS. date 2/29/96

Operation Permit by: Wesley Sparks RS. date 2/29/96

HEALTH DEPT. COPY: WHITE INSPECTION COPY (FINAL): GREEN OWNER COPY (FINAL): YELLOW INSPECTION COPY (INITIAL): PINK OWNER COPY (INITIAL): GOLD