# IREDELL COUNTY HEALTH DEPARTMENT

STATESVILLE 704-878-5305 MOORESVILLE 704-664-5281

## IMPROVEMENT PERMIT / AUTHORIZATION TO CONSTRUCT / OPERATION PERMIT / EXISTING SYSTEM INSPECTION

PERMIT# 106031 PIN# ~~4646207611.T~~ 4646278737 DATE 8/28/02

OWNER OR CONTRACTOR DIENST ENTERPRISES / Ryan Homes PHONE: Business 309-0123 Home

ADDRESS 14315 W. CATAWBA AVE. CORNELIUS NC

LOCATION WILLIAMSON - TR SUNDOWN - TR SUNDOWN COVE - TL CORONA - ON LT

SUBDIVISION ESTATES @ SUNDOWN BLOCK / SECTION LOT 7 LOT AREA 27127 ft² SITE CLASS. PS DESIGN FLOW 480 GPD L.T.A.R. .25 GPD/FT²

Septic Tank: 1000 Gallons; STB 794 Date 9-24-02

Pump Tank: 1000 Gallons; PT 283 Date 12-20-02

Pump Make: Model Serial No.

Nitrification Field: No Fields 1 Square Feet 640 Linear Feet 320

No Lines 4 @ 50' Trench Width 24" Max Trench Bottom Depth 36" Gravel Depth N/A

☑ New System ☐ Repair System Type: I, II, III, (IV), V, VI

System Description: LP PANEL

Repair System Description: SAME

Maintenance Agreement Required: ☑ Yes ☐ No

☑ House/Mod. Home ☐ Mobile Home ☐ Business ☐ Other

No. Bedrooms 4 No. Bathrooms 4 No. Employees


☐ Slab ☑ Crawl Space ☐ Basement w/plumbing ☐ Basement wo/plumbing

Water Supply: ☐ Individual ☐ Public ☑ ~~Community~~

Comments:/Conditions: 1) INLINE PUMP FILTER TO BE INSTALLED

Comments:/Conditions: Checked tanks & lines 2/6/03 MD
3/16" holes
Press, elect. & alarm 2/24/03

INITIAL SITE SKETCH 1" = 50'

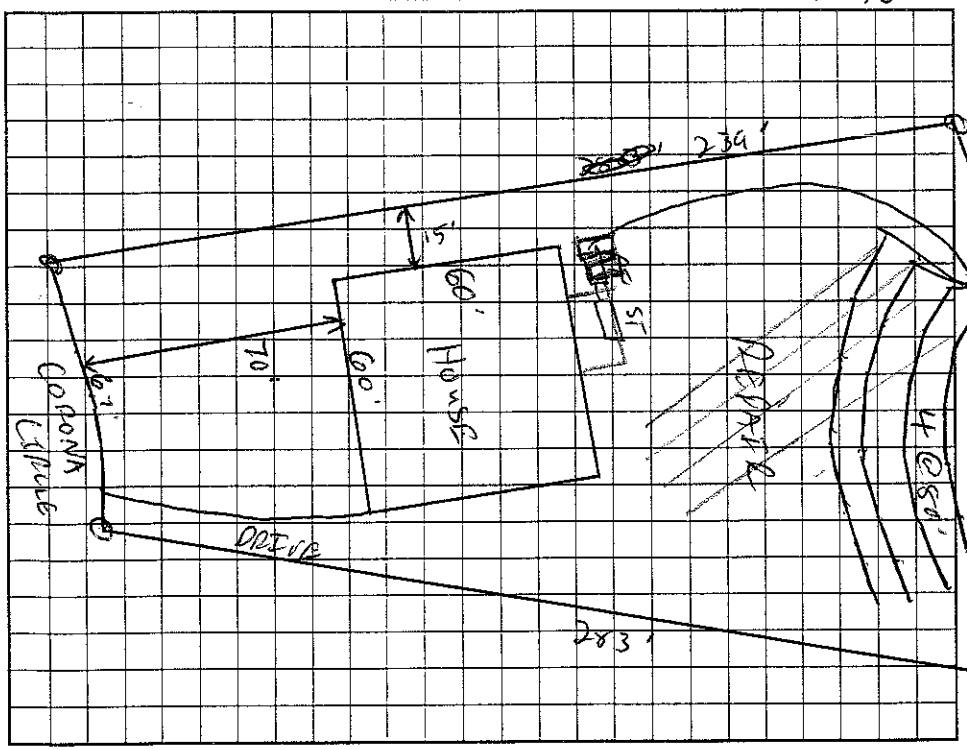


AS BUILT SKETCH

Maint. agreement ~~attached~~
"As Built" drawing attached

Permit can be suspended or revoked if any false information is supplied toward securing the permit/any unauthorized changes are made to the site/any unauthorized changes are made in the installation of the system. Improvement Permit with plat valid without expiration. Improvement Permit with site plan valid for sixty months. Authorization to Construct is valid for a period equal to that of Improvement Permit – not to exceed sixty months.

Signed: Robert B. Dienst date 9/20/02

Improvement Permit by: [signature] RS date 8/28/02

Authorization to Construct by: [signature] RS date 11/8/02

Installed by: R & H Inc

Operation Permit by: Maria H. Dotson RS. date 2/24/03

Existing System Inspection by: date

HEALTH DEPT. COPY: WHITE OWNER COPY (FINAL): YELLOW OWNER COPY (INITIAL): PINK