IREDELL COUNTY HEALTH DEPARTMENT

STATESVILLE 704-878-5305 MOORESVILLE 704-664-5281

IMPROVEMENT PERMIT / AUTHORIZATION TO CONSTRUCT / OPERATION PERMIT / EXISTING SYSTEM INSPECTION

PERMIT# 20685 PIN# 4646 27 9092 DATE 2/23/98

OWNER OR CONTRACTOR Ackerman Const Co. PHONE: Business 662-0145 Home

ADDRESS 1240 A River Hwy. Mooresville, NC. 28115

LOCATION 103 Shoreview Dr. ; Sundown Rd TR Shoreview Dr., 1st lot on (L)

SUBDIVISION Lake Norman BLOCK / SECTION LOT 22 LOT AREA .64Ac SITE CLASS. PS DESIGN FLOW 480 L.T.A.R. .3

Septic Tank: 1000 Gallons; STB Date

Pump Tank: Gallons; PT Date

Pump Make: Model Serial No.

Nitrification Field: No Fields 1 Square Feet 1200± Linear Feet 400±

No Lines 5 Trench Width 36" Max Trench Bottom Depth 36"

[X] New System [ ] Repair System Type: I, II, (III) IV, V, VI

System Description: Gravity - Ch. Plastic

Repair System Description: Same

Maintenance Agreement Required: [ ] Yes [X] No

[X] House/Mod. Home No. Bedrooms 4

[ ] Mobile Home No. Bathrooms 3

[ ] Business No. Employees

[ ] Other


Gravel Depth SAND. [ ] Slab [X] Crawl Space [ ] Basement w/plumbing [ ] Basement wo/plumbing

Water Supply: [X] Individual [ ] Public [ ] Community

Comments:/Conditions:

Comments:/Conditions:

INITIAL SITE SKETCH

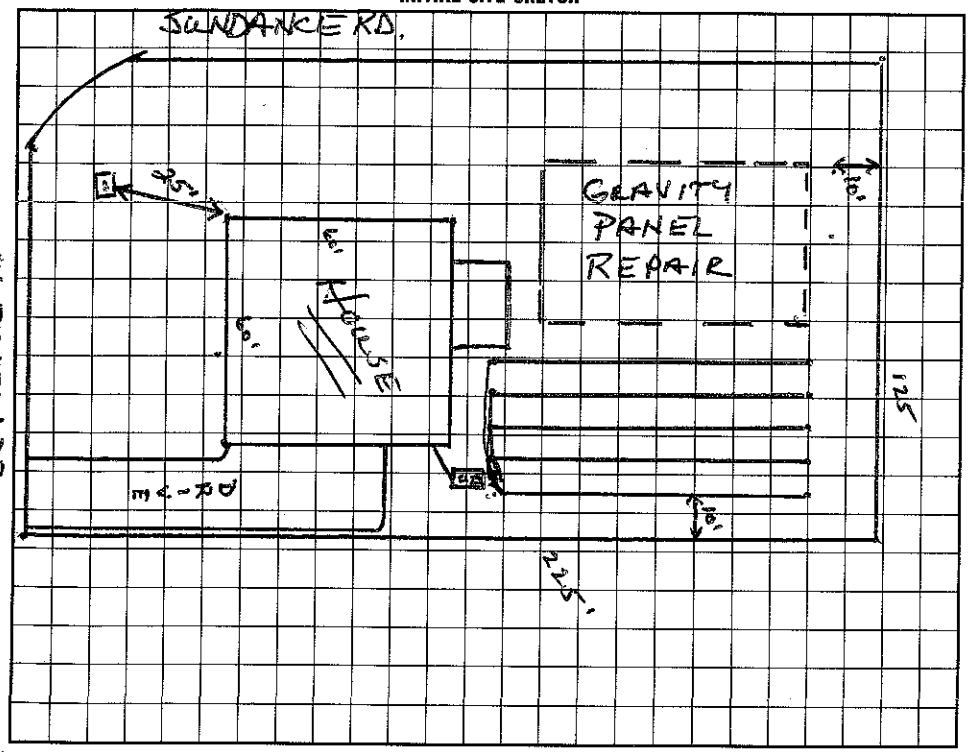

AS BUILT SKETCH

I understand that this permit can be suspended or revoked if any false information is supplied toward securing the permit/any unauthorized changes are made to the site/any unauthorized changes are made in the installation of the system. Improvement Permit with plat valid without expiration. Improvement Permit with site plan valid for sixty months. Authorization to Construct is valid for a period equal to that of Improvement Permit – not to exceed sixty months.

Signed: Jodi Ackerman date

Improvement Permit by: Wesley Sparks R.S. date 2/23/98

Authorization to Construct by: Wesley Sparks R.S. date 2/23/98

Installed by: Reade Eudy

Operation Permit by: Wesley Sparks R.S. date 8/4/98

Existing System Inspection by: Wesley Sparks R.S. date 8/4/98

HEALTH DEPT. COPY: WHITE INSPECTION COPY (FINAL): GREEN OWNER COPY (FINAL): YELLOW INSPECTION COPY (INITIAL): PINK OWNER COPY (INITIAL): GOLD