IREDELL COUNTY HEALTH DEPARTMENT

STATESVILLE 704-878-5305 MOORESVILLE 704-664-5281

IMPROVEMENT PERMIT / AUTHORIZATION TO CONSTRUCT / OPERATION PERMIT / EXISTING SYSTEM INSPECTION

PERMIT# 106101 PIN# ~~4646-20-9677.86~~ 4646-28-0354 DATE 8/27/02

OWNER OR CONTRACTOR DIENST ENTERPRISES / RYAN HOMES PHONE: Business 309-0123 Home

ADDRESS 19315 W. CATAWBA AVE SUITE 200 CORNELIUS

LOCATION WILLIAMSON - TR SUNDOWN - TR SUNDOWN COVE - ON LT #145

SUBDIVISION ESTATES @ SUNDOWN BLOCK / SECTION 2 LOT 86 LOT AREA 25,600ft² SITE CLASS. PS DESIGN FLOW 480GPD L.T.A.R. .3000 IF=2

Septic Tank: 1000 Gallons; STB 1941 Date 10-17-03
Pump Tank: Gallons; PT Date
Pump Make: Model Serial No.
Nitrification Field: No Fields 1 Square Feet 1200 Linear Feet 400
No Lines 4@100' Trench Width 36" Max Trench Bottom Depth 36" Gravel Depth N/A

☐ New System ☐ Repair System Type: I, II, III, IV, V, VI
System Description: GRAVITY, INNOVATIVE
Repair System Description: LP PANEL
Maintenance Agreement Required: ☐ Yes ☒ No


☒ House/Mod. Home No. Bedrooms 4
☐ Mobile Home No. Bathrooms 4
☐ Business No. Employees
☐ Other
☐ Slab ☒ Crawl Space ☐ Basement w/plumbing ☐ Basement wo/plumbing

Water Supply: ☐ Individual ☒ Public ☐ Community


Comments/Conditions:

Comments/Conditions: Filter installed

INITIAL SITE SKETCH 1" = 50'

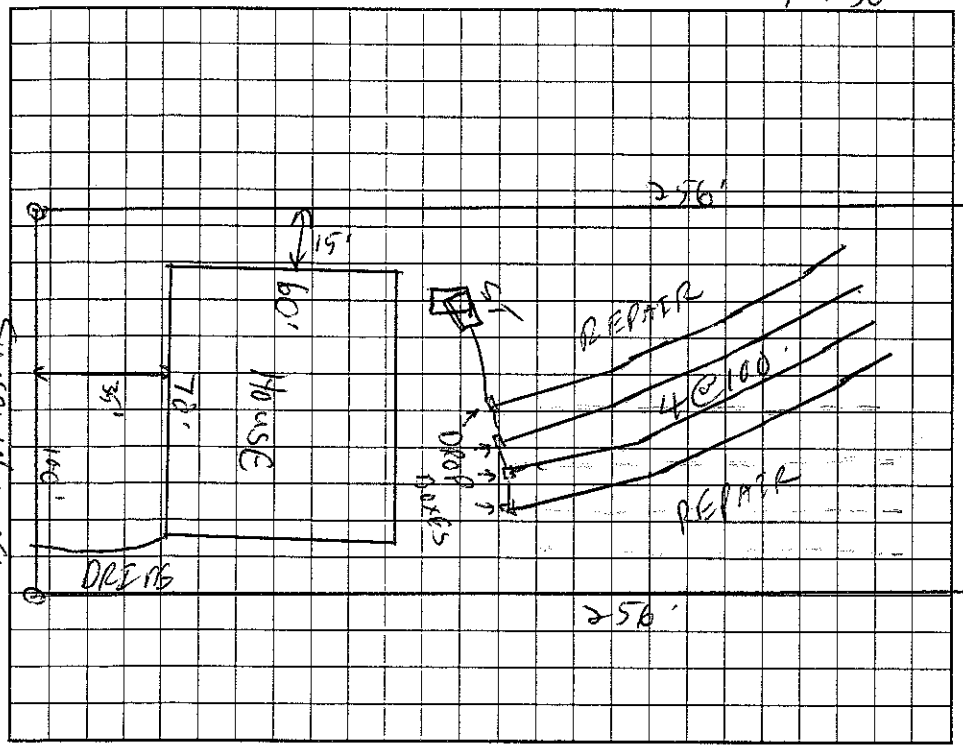

AS BUILT SKETCH

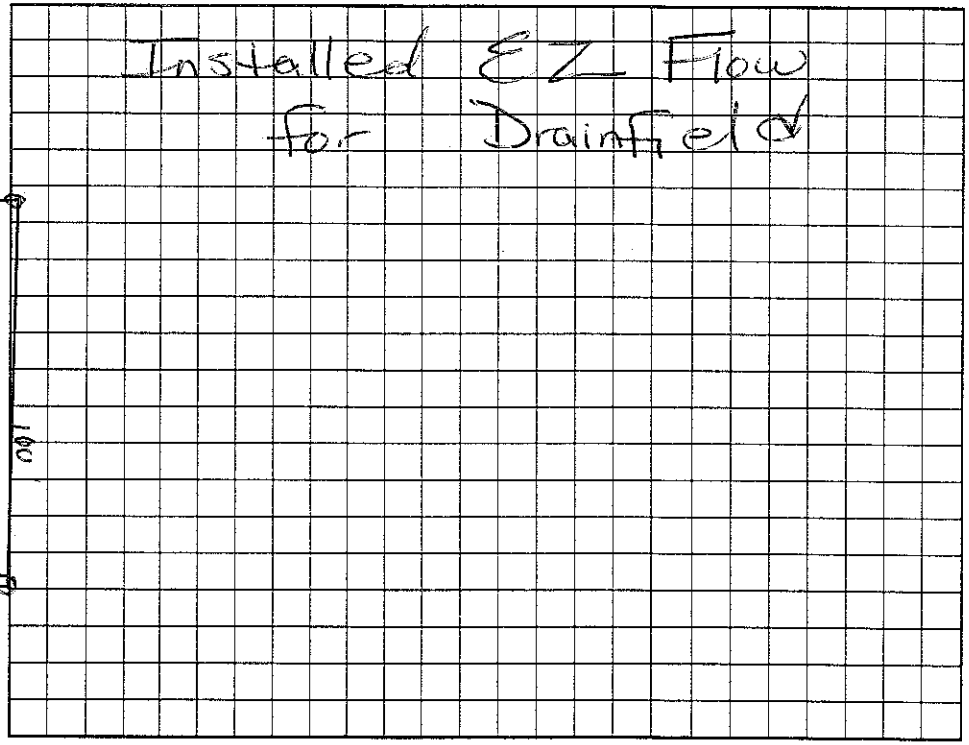

Permit can be suspended or revoked if any false information is supplied toward securing the permit/any unauthorized changes are made to the site/any unauthorized changes are made in the installation of the system. Improvement Permit with plat valid without expiration. Improvement Permit with site plan valid for sixty months. Authorization to Construct is valid for a period equal to that of Improvement Permit – not to exceed sixty months.

Signed: Robert B. Dienst date 9/20/02 Installed by: R & H Inc

Improvement Permit by: C. [signature] RS date 8/27/02 Operation Permit by: Maint. Tech Gatewood RS date 11/27/03

Authorization to Construct by: C. [signature] RS date 8/8/03 Existing System Inspection by: date

HEALTH DEPT. COPY: WHITE OWNER COPY (FINAL): YELLOW OWNER COPY (INITIAL): PINK