# IREDELL COUNTY HEALTH DEPARTMENT

Existing / Deck ones Ø

STATESVILLE 704-878-5305 MOORESVILLE 704-664-5281

## IMPROVEMENT PERMIT / AUTHORIZATION TO CONSTRUCT / OPERATION PERMIT / EXISTING SYSTEM INSPECTION

PERMIT # 156805 PIN # 4646281354.000 DATE 6/1/09

OWNER or APPLICANT Erika Medina PHONE: Business Home:

OWNER or APPLICANT ADDRESS 141 Sundown Cove Dr. Mooresville NC 28117

LOCATION / DIRECTIONS Williamson Rd. To Sundown Rd. TR Sundown Cove on Left

SUBDIVISION Sundown Cove BLOCK / SECTION LOT # 85 LOT AREA .59 DESIGN FLOW 480 L.T.A.R. Exis

Septic Tank 1000 Gallons: STB Date

Pump Tank 1000 Gallons: P T Date

Pump Make Model Serial #

Nitrification Field No Fields 1 No Lines 5 Linear Feet 350' Exis

Trench Width 24" Max. Trench Bottom Depth 36" Gravel Depth N/A

☐ New System ☐ Repair ☐ Expansion System Type I II III IV V VI

System Description: Existing System

Repair System Description:

Maintenance Agreement Required ☐ YES ☐ NO

☐ GRAVITY ☑ PRESSURE

☑ Residence No. Bedrooms 4

☐ Business No. Persons

☐ Other No. Employees

☐ Slab ☑ Crawl Space


☐ Basement w/plumbing ☐ Basement w/o plumbing

Water Supply: ☐ Private ☐ Public ☑ Community


Comments / Conditions

Comments / Conditions Nearest existing drainline is ≈12' from proposed Deck.

INITIAL SITE SKETCH

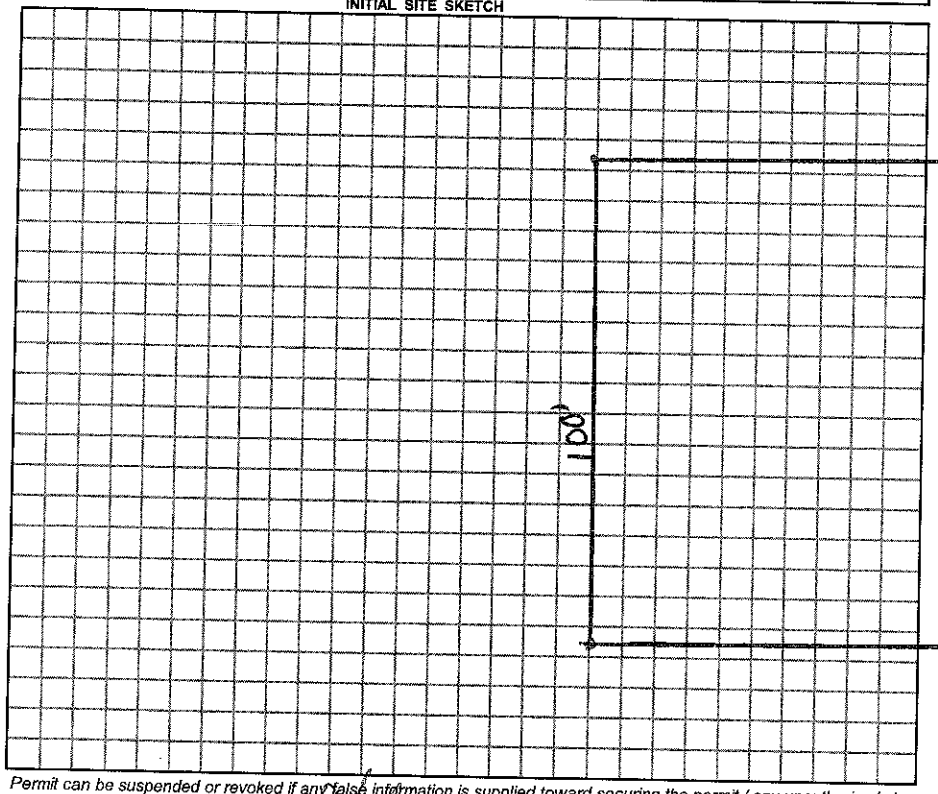


AS BUILT SKETCH

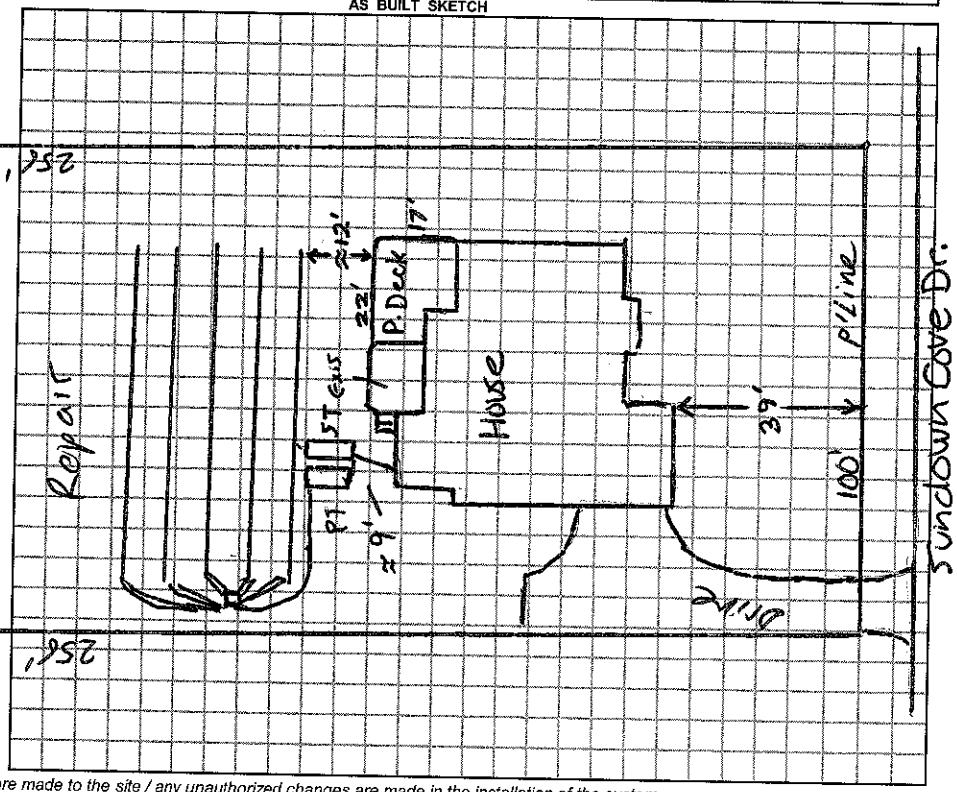


*Permit can be suspended or revoked if any false information is supplied toward securing the permit / any unauthorized changes are made to the site / any unauthorized changes are made in the installation of the system.*

☐ *IMPROVEMENT PERMIT w / plan valid without expiration.* ☐ *IMPROVEMENT PERMIT w / site plan valid for 60 mos.* ☐ *AUTHORIZATION TO CONSTRUCT valid for period equal to IMPROVEMENT PERMIT-not to exceed 60 mo.*

Owner / Applicant Signature: Date 6/5/09

Improvement Permit by: Date

Authorization to Construct by: Date

***YOU SHOULD CONTACT A LOCATOR SERVICE PRIOR TO ANY EXCAVATION.***

Installed by:

Operation Permit by: Date:

Existing System Inspected by: Anthony Coker Jr. RS Date: 6/1/09

WHITE COPY Environmental Health YELLOW COPY (Final) Owner / Applicant PINK COPY (Initial) Owner / Applicant