IREDELL COUNTY HEALTH DEPARTMENT

STATESVILLE 704-878-5305 MOORESVILLE 704-664-5281

IMPROVEMENT PERMIT / AUTHORIZATION TO CONSTRUCT / OPERATION PERMIT / EXISTING SYSTEM INSPECTION

11.00

PERMIT# 106120/119837 PIN# ~~4646 20 4671 78~~ 4646-28-1654 DATE 8/2/10

OWNER OR CONTRACTOR DEENST ENTERPRISES / RYAN HOMES PHONE: Business 309-0123 Home

ADDRESS 19315 W. CATAWBA AVE. SUITE 200 CORNELIUS NC 28031

LOCATION WILLIAMSON - TR SUNDOWN - TR SUNDOWN COVE - ON RT

SUBDIVISION ESTATES @ SUNDOWN BLOCK / SECTION 2 LOT 72 LOT AREA 25000 SF SITE CLASS. RS DESIGN FLOW 480GPD L.T.A.R. .36PD/KT=

Septic Tank: 1000 Gallons; STB 312 Date 3-20-04

Pump Tank: 1000 Gallons; PT 27 Date 4-28-04

Pump Make: Goulds Model WE0312M1 Serial No.

Nitrification Field: No Fields 1 Square Feet 540 Linear Feet 270

No Lines 3 @ 90' Trench Width 24" Max Trench Bottom Depth 36" Gravel Depth N/A

☑ New System ☐ Repair System Type: I, II, III, (IV), V, VI

System Description: LP PANEL

Repair System Description: SAME

Maintenance Agreement Required: ☑ Yes ☐ No

☑ House/Mod. Home No. Bedrooms 4

☐ Mobile Home No. Bathrooms 4

☐ Business No. Employees

☐ Other


☐ Slab ☑ Crawl Space ☐ Basement w/plumbing ☐ Basement wo/plumbing

Water Supply: ☐ Individual ☐ Public ☑ Community

Comments:/Conditions: 1) INLINE PUMP FILTER TO BE INSTALLED

Comments:/Conditions: Checked tanks & lines 6/2/04 MK
Pressure, elect & alarm 6/11/04

INITIAL SITE SKETCH

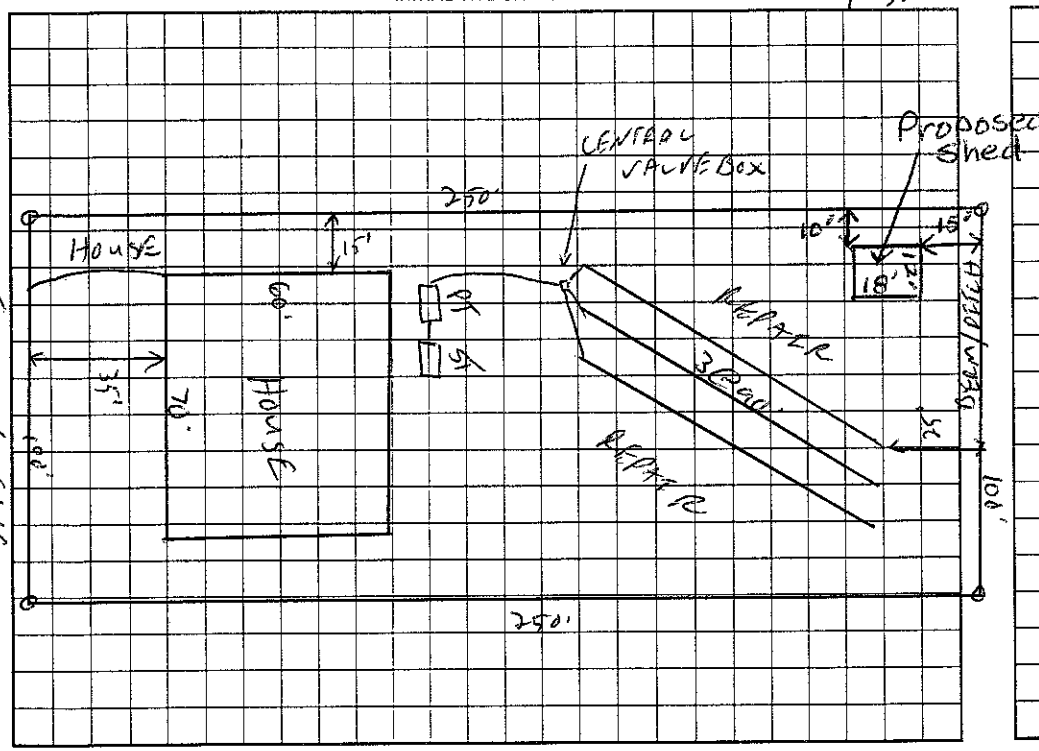

AS BUILT SKETCH

The proposed / existing Shed / Accessory Building addition does not appear to impact the existing septic system

**NOTE:

Judy Melville REHS

Date: 5-26-11

ICHD-Environmental Health Division

Permit can be suspended or revoked if any false information is supplied toward securing the permit/any unauthorized changes are made to the site/any unauthorized changes are made in the installation of the system. Improvement Permit with plat valid without expiration. Improvement Permit with site plan valid for sixty months. Authorization to Construct is valid for a period equal to that of Improvement Permit – not to exceed sixty months.

Signed: Robert B. Deenst date 9/20/02

Improvement Permit by: C. Lyle RS date 8/21/02

Authorization to Construct by: C. Lyle RS date 3/11/04

Installed by: R&H RS

Operation Permit by: Maria H. Dolan date 6/10/04

Existing System Inspection by: date

HEALTH DEPT. COPY: WHITE OWNER COPY (FINAL): YELLOW OWNER COPY (INITIAL): PINK