IREDELL COUNTY HEALTH DEPARTMENT *ENVIRONMENTAL HEALTH DIVISION*:

SITE PLAN WORKSHEET

SEE THE "SAMPLE SITE PLAN" BELOW. ***INCOMPLETE SITE PLANS WILL BE RETURNED TO YOU FOR COMPLETION AND MAY RESULT IN A DELAY IN THE ISSUANCE OF YOUR SEPTIC SYSTEM PERMIT!!!***

Place an (X) beside each item as you complete the site plan:

X **Property Line measurements are clearly identified…** X **All proposed structures are indicated…**

SHOW: proposed house or business footprint, wells, water lines, patios, pools and decks, and any other item that will occupy space on the site


X **Front and side setbacks from property line…** N/A **Preferred driveway location and configuration, preferred well location…**

N/A **Area you prefer your septic system to be placed…** X **North arrow, or other sufficient indicator of direction…**

Circle N/A on the following if appropriate:

X **Location of septic systems and wells within 100' of your property… N/A**

____ **Location of easements and rights of ways on your property.. (N/A)** ____ **Location of any designated wetlands on the property… N/A**

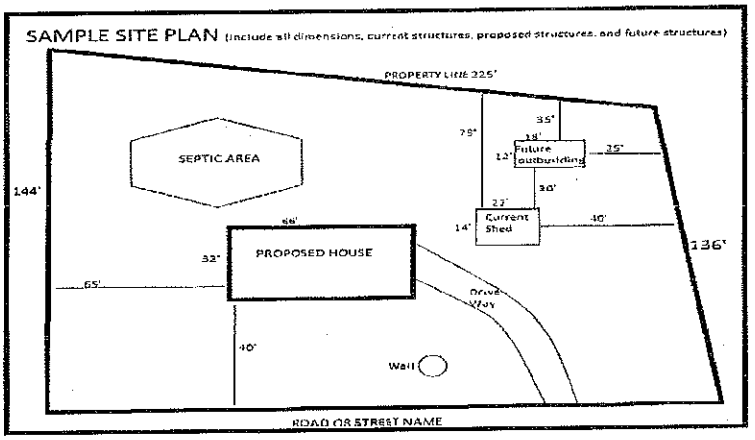

USE THIS SPACE TO DRAW YOUR SITE PLAN

Site sketch is provided on separate sheet, based on permit currently on file with the County. Purpose of this submission is for Environmental Health to determine whether the location of the existing system will allow for construction of an inground pool in our backyard, with the approximate placement and dimensions indicated in the sketch.

If, after inspection, Environmental Health determines that current system location would not support a pool, we request advice on:

- Alternate pool location and/or allowable pool dimensions
- Possible reconfiguration of septic lines to allow pool construction

Signature: _____ 11/24/15

REQUIRED **property owner or owner's legal representative signature.** **DATE**

IREDELL COUNTY HEALTH DEPARTMENT *ENVIRONMENTAL HEALTH DIVISION:*

SITE PLAN WORKSHEET

SEE THE "SAMPLE SITE PLAN" BELOW. ***INCOMPLETE SITE PLANS WILL BE RETURNED TO YOU FOR COMPLETION AND MAY RESULT IN A DELAY IN THE ISSUANCE OF YOUR SEPTIC SYSTEM PERMIT!!!***

Place an (X) beside each item as you complete the site plan:

__X__ **Property Line measurements are clearly identified…** __X__ **All proposed structures are indicated…**

SHOW: proposed house or business footprint, wells, water lines, patios, pools and decks, and any other item that will occupy space on the site


__X__ **Front and side setbacks from property line…** __N/A__ **Preferred driveway location and configuration, preferred well location…**

__N/A__ **Area you prefer your septic system to be placed…** __X__ **North arrow, or other sufficient indicator of direction…**


Circle N/A on the following if appropriate:

__X__ **Location of septic systems and wells within 100' of your property… N/A**

____ **Location of easements and rights of ways on your property.. N/A** ____ **Location of any designated wetlands on the property.. N/A**

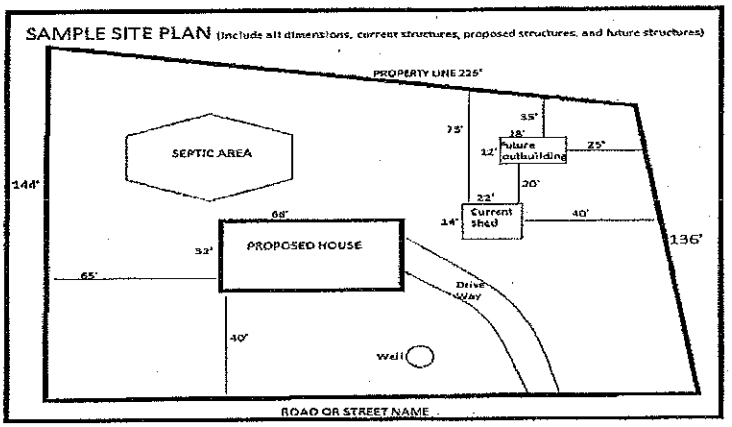

USE THIS SPACE TO DRAW YOUR SITE PLAN

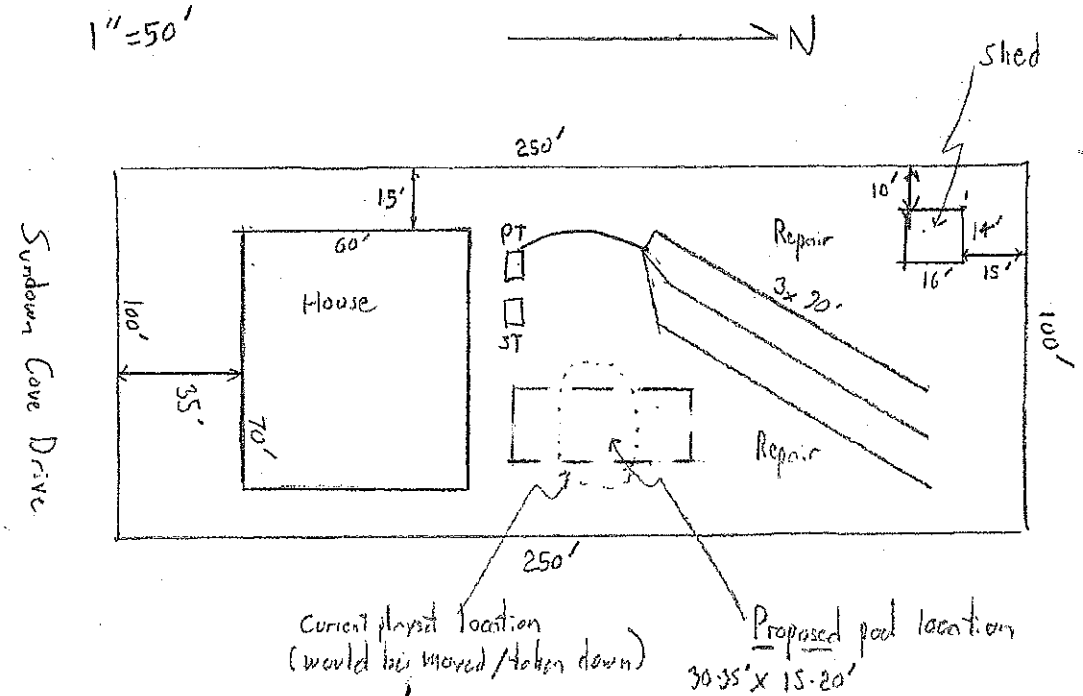


Signature: _____

REQUIRED **property owner or owner's legal representative signature.**

11/24/15

DATE

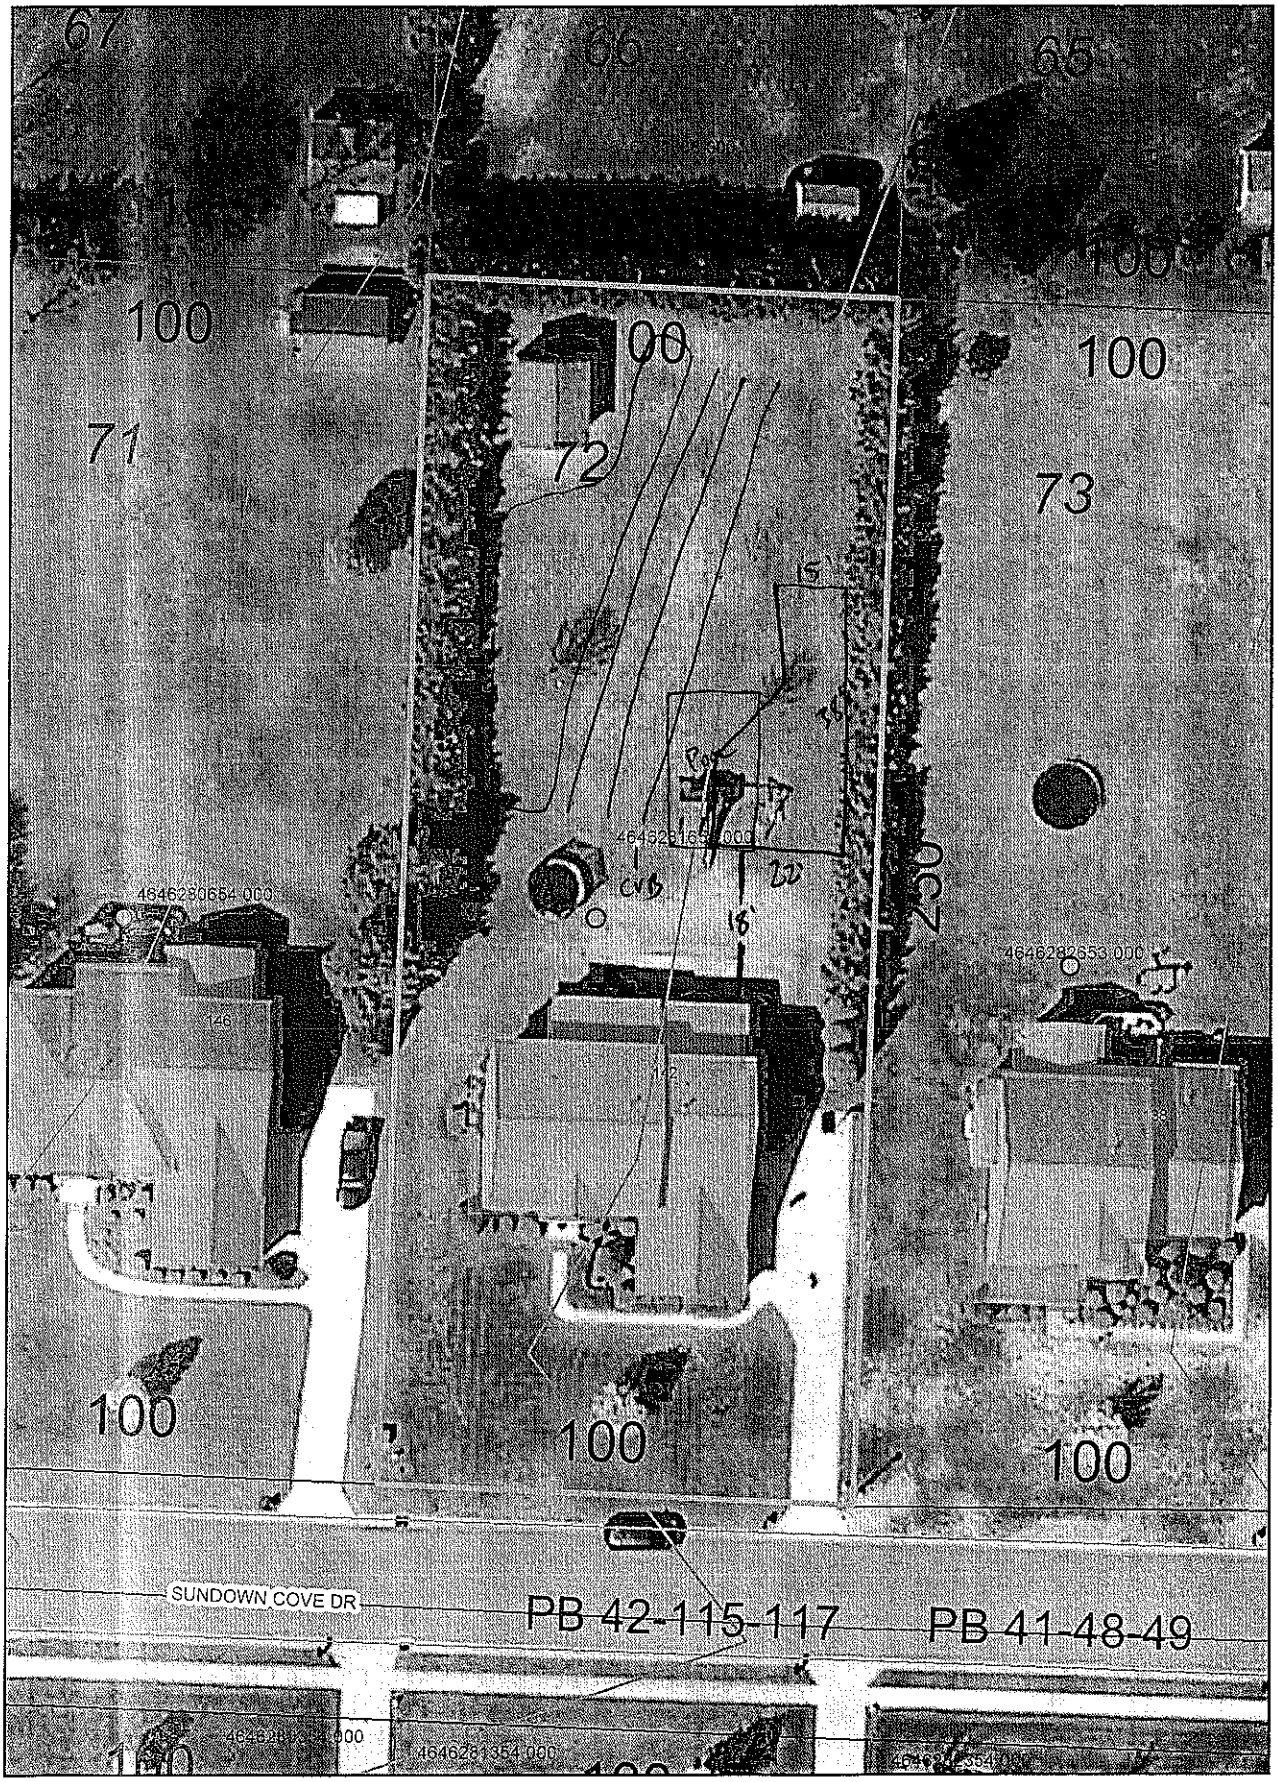
67
66
65
100
100
100
71
72
73
4646280654 000
4646282653 000
146
142
100
100
100
SUNDOWN COVE DR
PB 42-115-117
PB 41-48-49
4646281354 000

Robert Nance 11/24/15

IREDELL COUNTY HEALTH DEPARTMENT

STATESVILLE 704-878-5305 MOORESVILLE 704-664-5281

IMPROVEMENT PERMIT / AUTHORIZATION TO CONSTRUCT / OPERATION PERMIT / EXISTING SYSTEM INSPECTION

PERMIT# 106120/119837 PIN# 4646-28-1654 DATE 8/20/02

OWNER OR CONTACT DURANT ENTERPRISES/RYAN HOMES PHONE: Business 309-0123 Home

ADDRESS 1935 W. CAMPUS AVE. SUITE 200 CONCORD NC 28031

LOCATION WILLIAMSON - TR SUNDOWN - TR SUNDOWN COVE - ON RT

SUBDIVISION EXPRESS @ SUNDOWN BLOCK / SECTION 2 LOT 72 LOT AREA 21780 SF SITE CLASS. B DESIGN FLOW 440 GPD 1 T A N 3 BEDROOMS

Septic Tank 1000 Gallons Site 312 Date 5-20-04

Pump Tank 500 Gallons PT 27 Date 4-28-04

Pump Make Goulds Model US E03121M Serial No

Manifold Pipe No Risers 1 Square Feet 540 Linear Feet 276

No Lines 3 @ 90' Trench Width 24" Max Trench Bottom Depth 36" Gravel Depth 6"

☐ New System ☐ Repair System Type: I. C. ☐ E. C.

System Description: LP PANEL

Repair System Description: SAME

Maintenance Agreement Required: ☐ Yes ☐ No

☐ Residence ☐ Mobile Home ☐ Business ☐ Other

No. Bedrooms 4 No. Bathrooms 4 No. Employees


☐ Slab ☐ Crawl Space ☐ Basement w/plumbing ☐ Basement w/o plumbing

Water Supply: ☐ Individual ☐ Public (Community)

Comments/Conditions: 1) INLINE SAND FILTER TO BE INSTALLED

Comments/Conditions: Checked tanks & lines 6/2/04 TMK
Pressure, reset & alarm 6/11/04

INITIAL SITE SKETCH 1"=50'

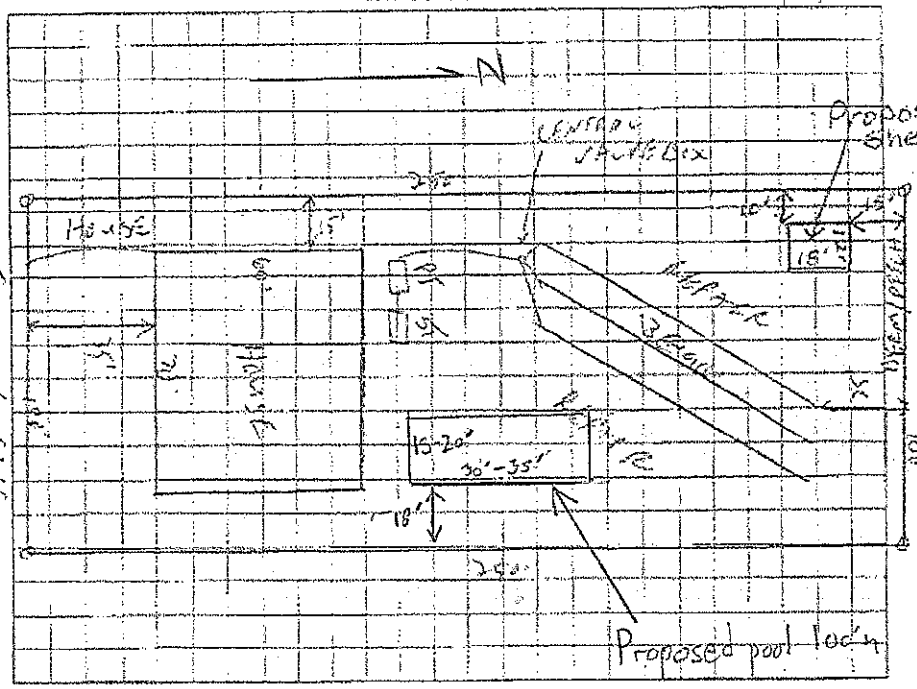

AS BUILT SKETCH

The proposed / existing Shed / Accessory Building addition does not appear to impact the existing septic system

**NOTE:

Jerry Melville REHS

Date: 5-26-11

ICHD-Environmental Health Division

Permit can be suspended or revoked if any false information is supplied toward securing the permit, any unauthorized changes are made to the site, any unauthorized changes are made in the installation of the system. Improvement Permit with plat valid with operation/improvement Permit with site plan valid for sixty months. Authorization to Construct is valid for a period equal to that of Improvement Permit -- not to exceed sixty months.

Signed: Robert B. Durant date 9/20/02

Improvement Permit by: RS date 8/21/02

Authorization to Construct by: RS date 3/1/04

Installed by: R&H KS

Operation Permit by: date 6/16/04

Existing System Inspection by: date

HEALTH DEPT COPY-WHITE OWNER COPY-PINK & YELLOW OWNER COPY-IN TAX FILE