IREDELL COUNTY HEALTH DEPARTMENT

STATESVILLE 704-878-5305 MOORESVILLE 704-664-5281

IMPROVEMENT PERMIT / AUTHORIZATION TO CONSTRUCT / OPERATION PERMIT / EXISTING SYSTEM INSPECTI

PERMIT# 40 106133 PIN# ~~4646204611.91~~ 4646-28-2008 DATE 9/27/02

OWNER OR CONTRACTOR DIENST ENTERPRISES / Ryan Homes PHONE: Business 309-0123 Home

ADDRESS 19315 W. CATAWBA CORNELIUS NC 28031

LOCATION WILLIAMSON - TR SUNDOWN - TR SUNDOWN COVE - TL CORONA - ON RT

SUBDIVISION ESTATES @ SUNDOWN BLOCK / SECTION 2 LOT 91 LOT AREA 25475 ft² SITE CLASS PS DESIGN FLOW 480GPD L.T.A.R. ~ .25 ac-ft/ft²

Septic Tank: 1000 Gallons; STB 312 Date 10-7-03

Pump Tank: 1000 Gallons; PT 283 Date 9-27-03

Pump Make: Model Serial No.

Nitrification Field: No Fields 1 Square Feet 700 Linear Feet 350

No Lines 5@70' Trench Width 24" Max Trench Bottom Depth 36" Gravel Depth N/A

☑ New System ☐ Repair System Type: I, II, III, IV, V, VI

System Description: LP PANEL

Repair System Description: SAME

Maintenance Agreement Required: ☑ Yes ☐ No

☑ House/Mod. Home ☐ Mobile Home ☐ Business ☐ Other

No. Bedrooms 4 No. Bathrooms 2 No. Employees


Water Supply: ☐ Individual ☐ Public ☑ Community

☐ Slab ☑ Crawl Space ☐ Basement w/plumbing ☐ Basement wo/plumbing


Comments:/Conditions: 1) INLINE PUMP FILTER TO BE INSTALLED

Comments:/Conditions: Filter installed
Checked tanks & lines 11/12/03 MD
Pres. elect. & alarm 11/25/03 MD

INITIAL SITE SKETCH 1"=50'

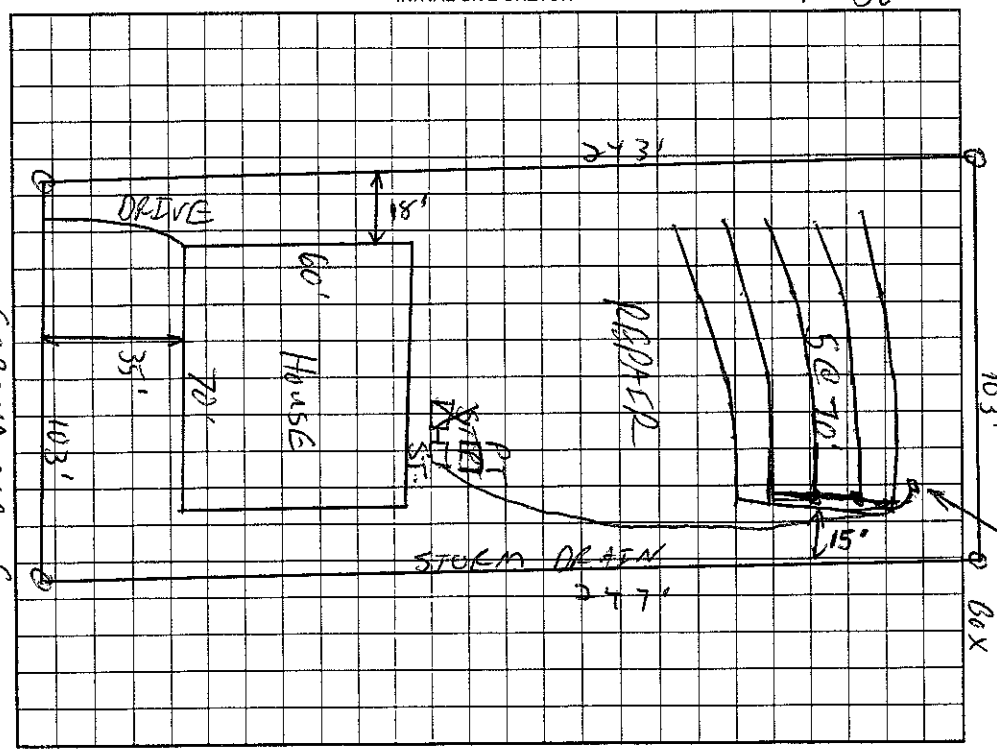

AS BUILT SKETCH

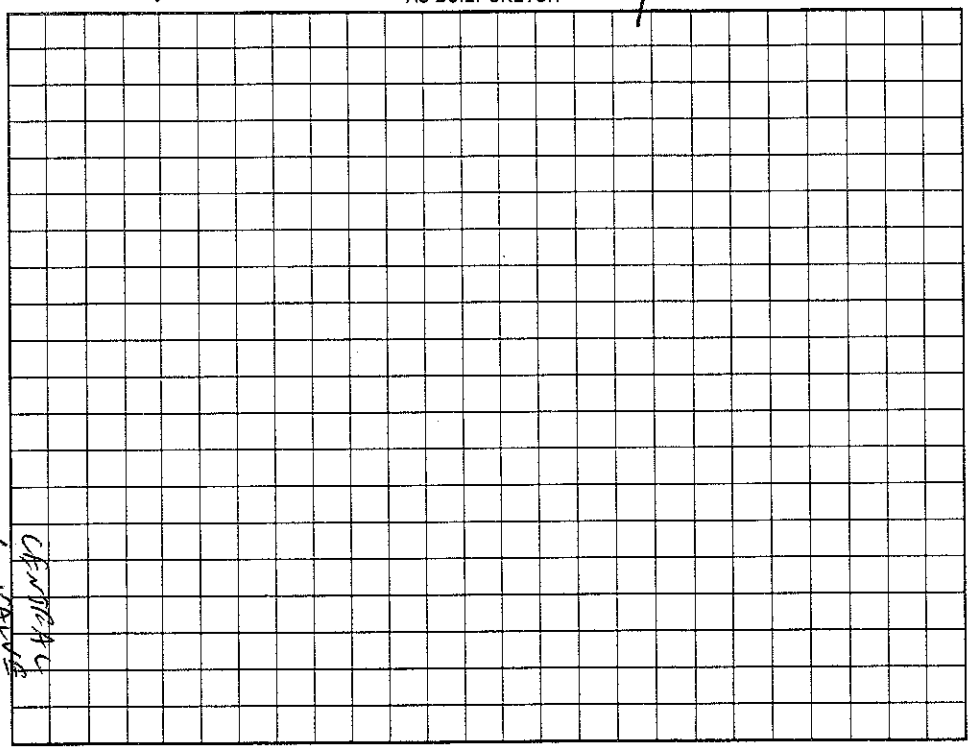

Permit can be suspended or revoked if any false information is supplied toward securing the permit/any unauthorized changes are made to the site/any unauthorized changes are made in the installation of the system. Improvement Permit with plat valid without expiration. Improvement Permit with site plan valid for sixty months. Authorization to Construct is valid for a period equal to that of Improvement Permit – not to exceed sixty months.

Signed: Robert B. Dienst date 9/20/02

Improvement Permit by: C. L. Z RS date 8/27/02

Authorization to Construct by: RS date 8/8/03

Installed by: R & H Inc R.S.

Operation Permit by: Mark Hilton RS date 11/25/03

Existing System Inspection by: date

HEALTH DEPT. COPY: WHITE OWNER COPY (FINAL): YELLOW OWNER COPY (INITIAL): PINK