IREDELL COUNTY HEALTH DEPARTMENT

STATESVILLE 704-878-5305 MOORESVILLE 704-664-5281

IMPROVEMENT PERMIT / AUTHORIZATION TO CONSTRUCT / OPERATION PERMIT / EXISTING SYSTEM INSPECT'

PERMIT# 106133 PIN# ~~4646204611.91~~ 4646-28-2008 DATE 9/27/02

OWNER OR CONTRACTOR DIENST ENTERPRISES / Ryan Homes PHONE: Business 309-0123 Home

ADDRESS 19315 W. CATAWBA CORNELIUS NC 28031

LOCATION WILLIAMSON - TR SUNDOWN - TR SUNDOWN COVE - TL CORONA - ON RT

SUBDIVISION ESTATES @ SUNDOWN BLOCK / SECTION 2 LOT 91 LOT AREA 25475 SF SITE CLASS. PS DESIGN FLOW 480 GPD L.T.A.R. ~, 25 sq ft

Septic Tank: 1000 Gallons: STB 312 Date 10-7-03
Pump Tank: 1000 Gallons; PT 283 Date 9-27-03
Pump Make: Model Serial No.
Nitrification Field: No Fields 1 Square Feet 700 Linear Feet 350
No Lines 5 @ 70' Trench Width 24" Max Trench Bottom Depth 36" Gravel Depth N/A

☑ New System ☐ Repair System Type: I, II, III, (IV), V, VI
System Description: LP PANEL
Repair System Description: SAME
Maintenance Agreement Required: ☑ Yes ☐ No


☑ House/Mod. Home No. Bedrooms 4
☐ Mobile Home No. Bathrooms 4
☐ Business No. Employees
☐ Other
☐ Slab ☑ Crawl Space ☐ Basement w/plumbing ☐ Basement wo/plumbing

Water Supply:
☐ Individual
☐ Public
☑ Community

Comments:/Conditions: 1) INLINE PUMP FILTER TO BE INSTALLED

Comments:/Conditions: Filter installed
Checked tanks & lines 11/12/03 MD
Pres. elect. & alarm 11/25/03 MD

INITIAL SITE SKETCH 1" = 50'

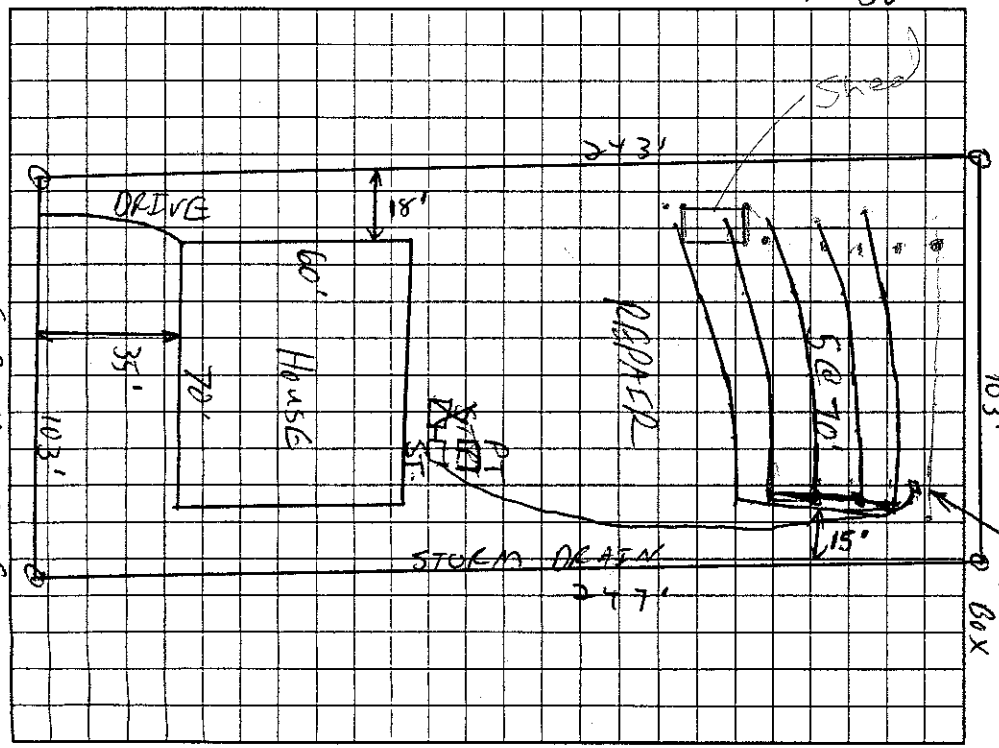

AS BUILT SKETCH

Permit can be suspended or revoked if any false information is supplied toward securing the permit/any unauthorized changes are made to the site/any unauthorized changes are made in the installation of the system. Improvement Permit with plat valid without expiration) Improvement Permit with site plan valid for sixty months. Authorization to Construct is valid for a period equal to that of Improvement Permit – not to exceed sixty months.

Signed: Robert B. Dienst date 9/20/02
Improvement Permit by: RS date 8/27/02
Authorization to Construct by: RS date 8/8/03

Installed by: R & H Inc RS
Operation Permit by: Marvin Urban date 11/25/
Existing System Inspection by: date