IREDELL COUNTY HEALTH DEPARTMENT

STATESVILLE 704-878-5305 $245 MOORESVILLE 704-664-5281

IMPROVEMENT PERMIT / AUTHORIZATION TO CONSTRUCT / OPERATION PERMIT / EXISTING SYSTEM INSPECTION

PERMIT# 106098 PIN# ~~4646 20 4611.84~~ 4646-28-2354 DATE 7/2/03

OWNER OR CONTRACTOR Ryan Homes PHONE: Business 704-875-9887 Home

ADDRESS 9920 King Ave. Suite 110 Huntersville NC 28078

LOCATION Williamson, TR Sundown, TR Sundown Cove on Lt.

SUBDIVISION Est. @ Sundown BLOCK / SECTION 2 LOT 84 LOT AREA 25,600 Ft² SITE CLASS PS DESIGN FLOW 600 L.T.A.R. 0.3

Septic Tank: 1500 Gallons; STB 338 Date 8-23-03
Pump Tank: 1500 Gallons; PT 338 Date
Pump Make: Model Serial No.
Nitrification Field: No Fields 1 Square Feet 990' Linear Feet 330
No Lines 5@66' Trench Width 24" or 36" Max Trench Bottom Depth 36" Gravel Depth —

☒ New System ☐ Repair System Type: I, II, III, (IV) V, VI
System Description: LP Pandl Block
Repair System Description: Same
Maintenance Agreement Required: ☒ Yes ☐ No

☒ House/Mod. Home No. Bedrooms 5
☐ Mobile Home No. Bathrooms 5
☐ Business No. Employees
☐ Other


☐ Slab ☒ Crawl Space ☐ Basement w/plumbing ☐ Basement wo/plumbing

Water Supply:
☐ Individual
☐ Public
☒ Community


Comments:/Conditions: 8FOC 9FOC

Comments:/Conditions: Checked tanks 10/3/03 MD No date on Checked lines 10/17/03 Pres. elect & alarm 10/28/03 MD

INITIAL SITE SKETCH

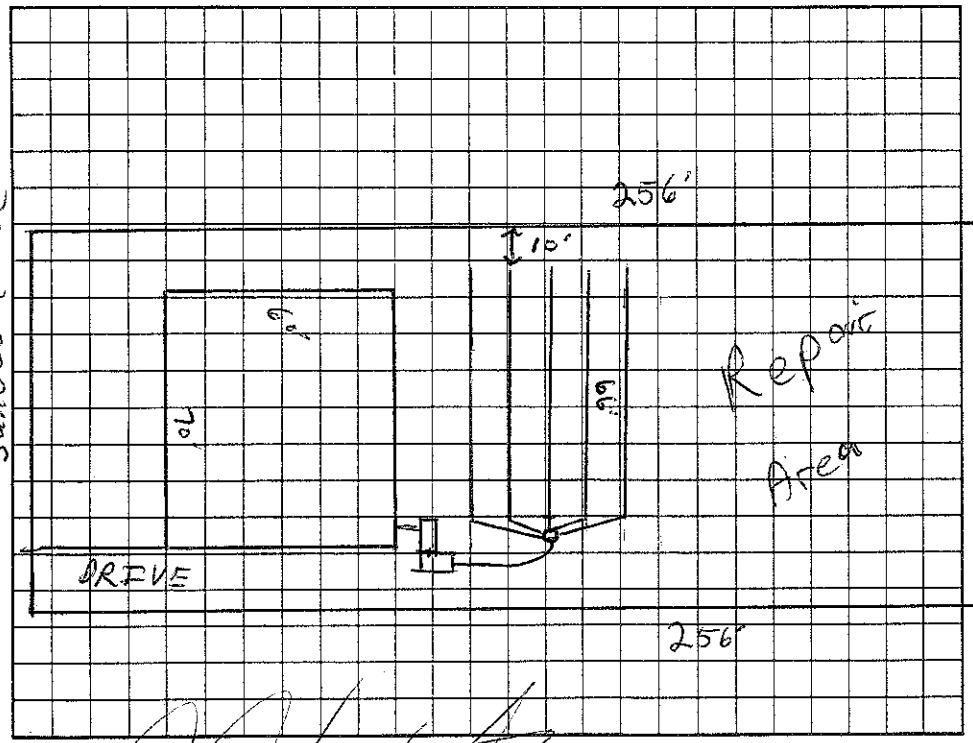

AS BUILT SKETCH

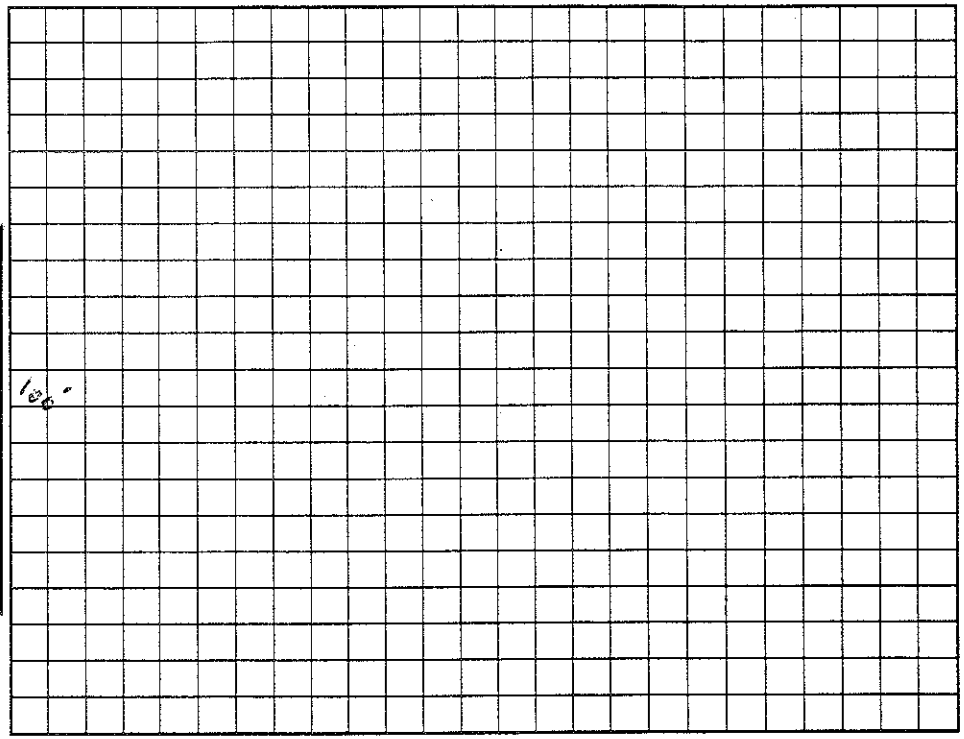

Permit can be suspended or revoked if any false information is supplied toward securing the permit/any unauthorized changes are made to the site/any unauthorized changes are made in the installation of the system. Improvement Permit with plat valid without expiration. Improvement Permit with site plan valid for sixty months. Authorization to Construct is valid for a period equal to that of Improvement Permit – not to exceed sixty months.

Signed: date 7/3/03

Improvement Permit by: RS date 7/2/03

Authorization to Construct by: RS date 7/2/03

Installed by: R & H Inc

Operation Permit by: Mark Hilton RS date 10/29/03

Existing System Inspection by: date

HEALTH DEPT. COPY: WHITE OWNER COPY (FINAL): YELLOW OWNER COPY (INITIAL): PINK