IREDELL COUNTY HEALTH DEPARTMENT

STATESVILLE 704-878-5305 MOORESVILLE 704-664-5281

IMPROVEMENT PERMIT / AUTHORIZATION TO CONSTRUCT / OPERATION PERMIT / EXISTING SYSTEM INSPECTION

PERMIT# 106121 PIN# ~~4646 30 4611.75~~ 4646-28-2653 DATE 8/21/02

OWNER OR CONTRACTOR DIENST ENTERPRISES / NVR INC. / RYAN HOMES PHONE: Business 309-0123 Home

ADDRESS 19315 N. CATAWBA AVE SUITE 200 CORNELIUS NC 28031 #138

LOCATION WILLIAMSON - TR SUNDOWN - TR SUNDOWN COVE - ON RT

SUBDIVISION ESTATES @ SUNDOWN BLOCK / SECTION 2 LOT 73 LOT AREA 25000 ft2 SITE CLASS. RS DESIGN FLOW ~~600~~ 360 L.T.A.R. .3600/Ft2

Septic Tank: 1000 Gallons; STB 312 Date 10-18-03

Pump Tank: 1000 Gallons; PT 27 Date 1-2-04

Pump Make: Model Serial No.

Nitrification Field: No Fields 1 Square Feet @ 420 Linear Feet 210

No Lines 3@ 70' Trench Width 24" Max Trench Bottom Depth 36" Gravel Depth N/A

☑ New System ☐ Repair System Type: I, II, III, (IV) V, VI

System Description: LP PANEL

Repair System Description: SAME

Maintenance Agreement Required: ☑ Yes ☐ No

☑ House/Mod. Home No. Bedrooms 3B

☐ Mobile Home No. Bathrooms 3

☐ Business No. Employees

☐ Other


☐ Slab ☑ Crawl Space ☐ Basement w/plumbing ☐ Basement wo/plumbing

Water Supply: ☐ Individual ☐ Public ☑ Community


Comments:/Conditions: 1) INLINE PUMP FILTER TO BE INSTALLED

Comments:/Conditions: Checked drainlines 2/11/04
Drive on other side
3/16" hole drilled

INITIAL SITE SKETCH 1"=50'

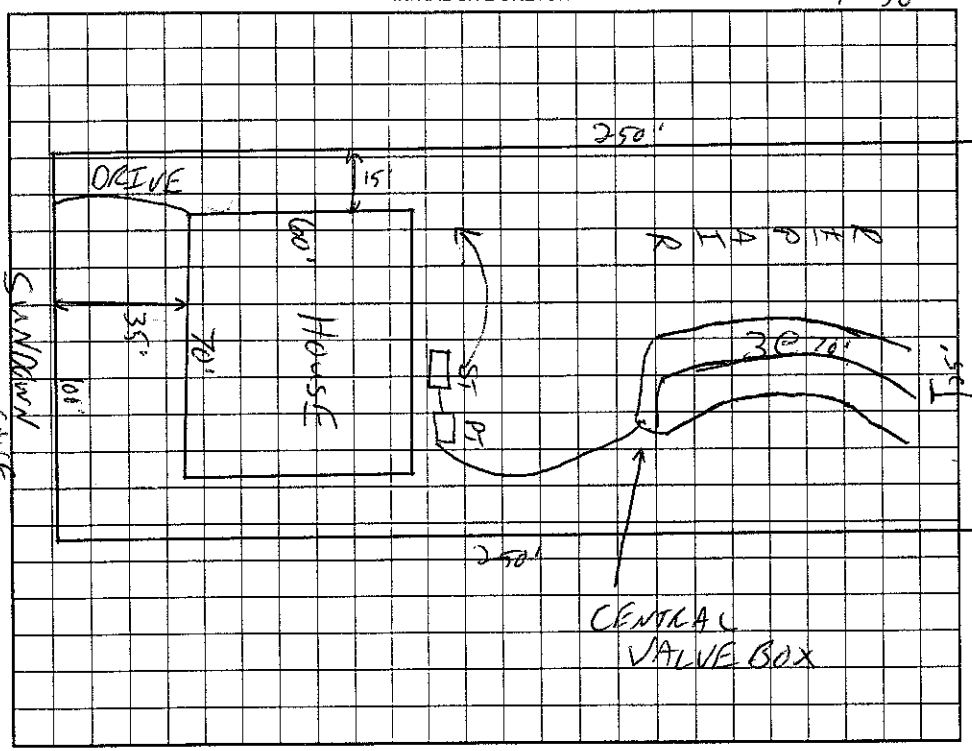

AS BUILT SKETCH

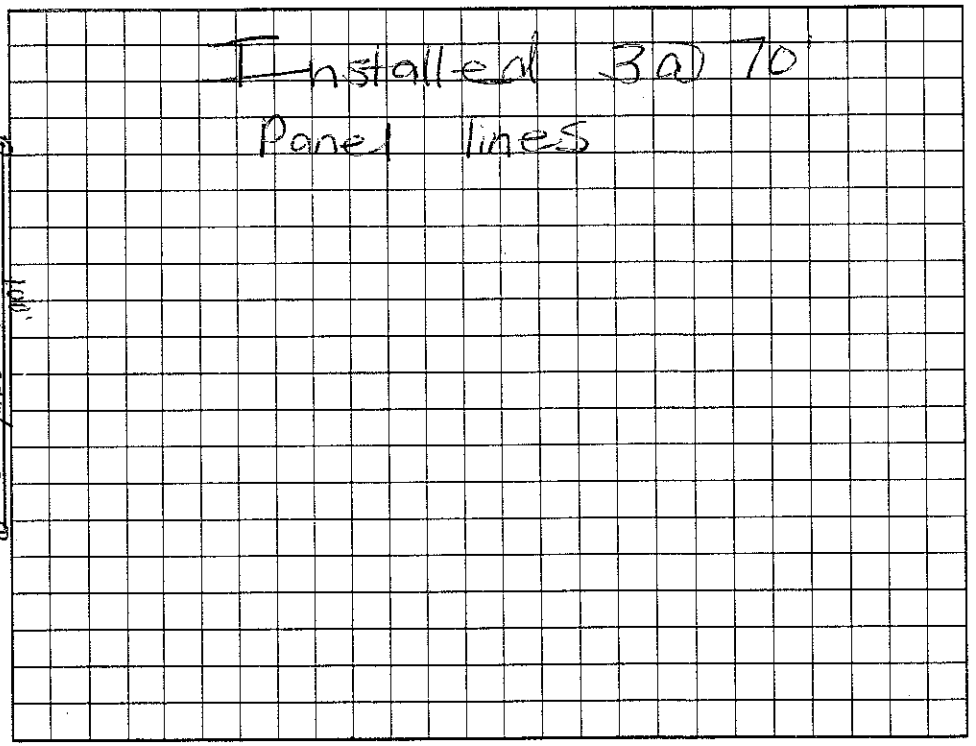

Permit can be suspended or revoked if any false information is supplied toward securing the permit/any unauthorized changes are made to the site/any unauthorized changes are made in the installation of the system. Improvement Permit with plat valid without expiration. ~~Improvement Permit with site plan~~ valid for sixty months. Authorization to Construct is valid for a period equal to that of Improvement Permit – not to exceed sixty months.

Signed: Robert B. Dienst date 9/20/02

Improvement Permit by: C. Gaz RS date 8/21/02

Authorization to Construct by: C. Gaz RS date 10/29/02

Installed by: R & A Inc

Operation Permit by: Maria Hill Labao RS date 2/13/04

Existing System Inspection by: date

HEALTH DEPT. COPY: WHITE OWNER COPY (FINAL): YELLOW OWNER COPY (INITIAL): PINK