3:00-3:30

IREDELL COUNTY HEALTH DEPARTMENT

STATESVILLE 704-878-5305 MOORESVILLE 704-664-5281

IMPROVEMENT PERMIT / AUTHORIZATION TO CONSTRUCT / OPERATION PERMIT / EXISTING SYSTEM INSPECTION

PERMIT# 107322 PIN# ~~4646 28 4611 65~~ 4646-28-2878 DATE 8/19/02

OWNER OR CONTRACTOR DIENST ENTERPRISES / Ryan Homes PHONE: Business 309-0123 Home

ADDRESS 19315 W. CATAWBA - CORNELIUS NC 28031

LOCATION WILLIAMSON - TR SUNDOWN RD - TR SUNDOWN COVE - TR CORONA - TL CORONA - ON LT

SUBDIVISION ESTATES @ SUNDOWN BLOCK / SECTION 2 LOT 65 LOT AREA 25000 ft² SITE CLASS. PS DESIGN FLOW 480GPD L.T.A.R. ~.25GPD/FT²

Septic Tank: 1000 Gallons; STB 312 Date 10/8/04
Pump Tank: 1000 Gallons; PT 283 Date 10/2/04
Pump Make: ~~Meyers~~ Goulds Model LVF0312M1 Series No. 21813B13 36
Nitrification Field: No Fields 1 Square Feet 640 Linear Feet 320
No Lines 3 Trench Width 24" Max Trench Bottom Depth 36" Gravel Depth N/A

☑ New System ☐ Repair System Type: I, II, III, IV, V, VI
System Description: LP PANEL
Repair System Description: SAME
Maintenance Agreement Required: ☑ Yes ☐ No


☑ House/Mod. Home No. Bedrooms 4
☐ Mobile Home No. Bathrooms 4
☐ Business No. Employees
☐ Other
☐ Slab ☑ Crawl Space ☐ Basement w/plumbing ☐ Basement wo/plumbing

Water Supply: ☐ Individual ☐ Public ☑ Community


Comments:/Conditions: 1) INLINE PUMP FILTER TO BE INSTALLED

Comments:/Conditions: Checked tanks & lines 11/19/04 mc

INITIAL SITE SKETCH 1" = 50'

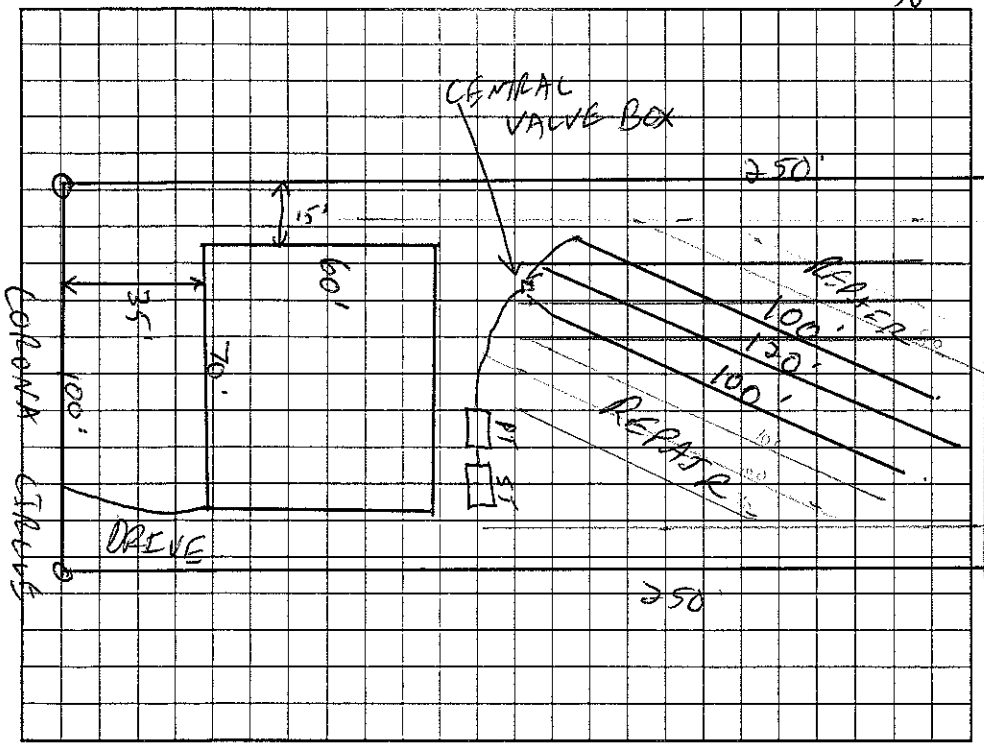

AS BUILT SKETCH

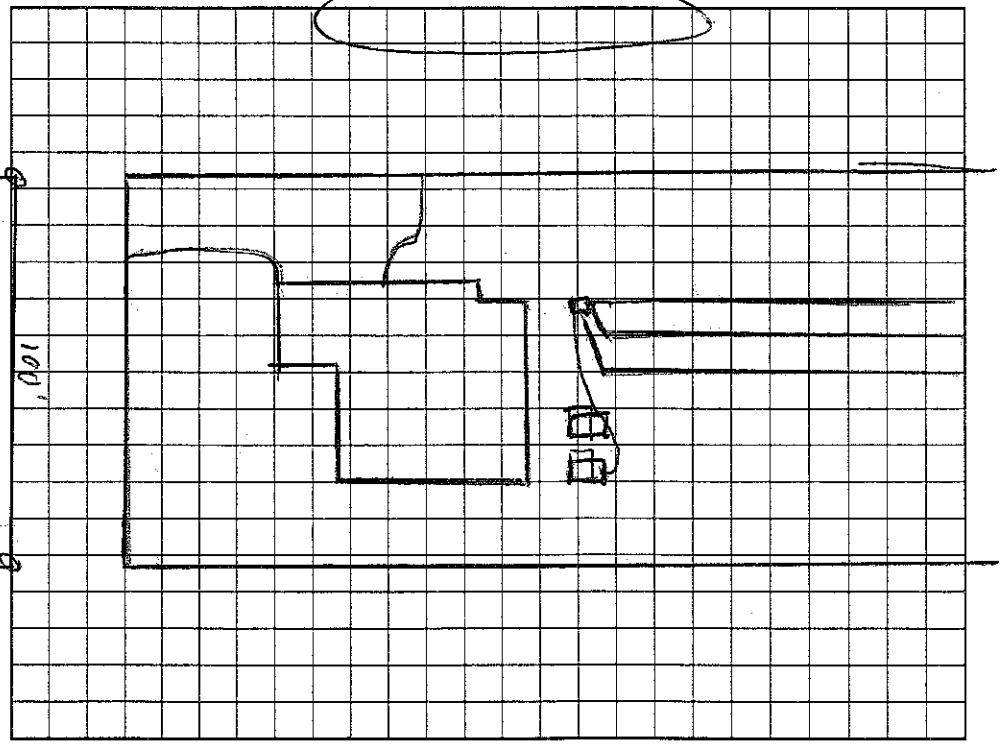

Permit can be suspended or revoked if any false information is supplied toward securing the permit/any unauthorized changes are made to the site/any unauthorized changes are made in the installation of the system. Improvement Permit with plat valid without expiration. Improvement Permit with site plan valid for sixty months. Authorization to Construct is valid for a period equal to that of Improvement Permit – not to exceed sixty months.

Signed: Robert R. Dienst date 9/20/02

Improvement Permit by: [signature] date 8/19/02

Authorization to Construct by: [signature] RS date 9/10/04

Installed by: R & H date

Operation Permit by: [signature] date 12/16/04

Existing System Inspection by: date

HEALTH DEPT. COPY: WHITE OWNER COPY (FINAL): YELLOW OWNER COPY (INITIAL): PINK