3'30

IREDELL COUNTY HEALTH DEPARTMENT

STATESVILLE 704-878-5305 MOORESVILLE 704-664-5281

IMPROVEMENT PERMIT / AUTHORIZATION TO CONSTRUCT / OPERATION PERMIT / EXISTING SYSTEM INSPECTION

PERMIT# 106094 PIN# ~~4646-20-4611.83~~ 4646-28-3353 DATE 8/27/02

OWNER OR CONTRACTOR DIENST ENTERPRISES PHONE: Business 704-0103 Home

ADDRESS 19 315 W. CATAWBA AVE SUITE 200 CORNELIUS NC 28031

LOCATION WILLIAMSON - TR SUNDOWN - TR SUNDOWN COVE ON LT

SUBDIVISION ESTATES @ SUNDOWN BLOCK / SECTION 2 LOT 83 LOT AREA .25600 FT² SITE CLASS. RS DESIGN FLOW ~~480.00~~ L.T.A.R. .25600/FT²

Septic Tank: 1000 Gallons; STB 312 Date 1-18-04
Pump Tank: 1000 Gallons; PT 27 Date 2-12-04
Pump Make: Model Serial No.
Nitrification Field: No Fields 1 Square Feet 660 Linear Feet 330
No Lines 3@110' Trench Width 24" Max Trench Bottom Depth 36" Gravel Depth N/A

☑ New System ☐ Repair System Type: I, II, III, ☑ IV, V, VI
System Description: LP PANEL
Repair System Description: SAME
Maintenance Agreement Required: ☑ Yes ☐ No


☑ House/Mod. Home No. Bedrooms 4
☐ Mobile Home No. Bathrooms 4
☐ Business No. Employees
☐ Other
☐ Slab ☑ Crawl Space ☐ Basement w/plumbing ☐ Basement wo/plumbing

Water Supply: ☐ Individual ☐ Public ☑ Community

Comments/Conditions: 1) IN LINE PUMP FILTER TO BE INSTALLED


Comments/Conditions: Reviewed Site plans & Building plans 12/2/03, essentially in Compliance with original permit. Press, Elect & Alarm 4/6/04

INITIAL SITE SKETCH 1"=50'

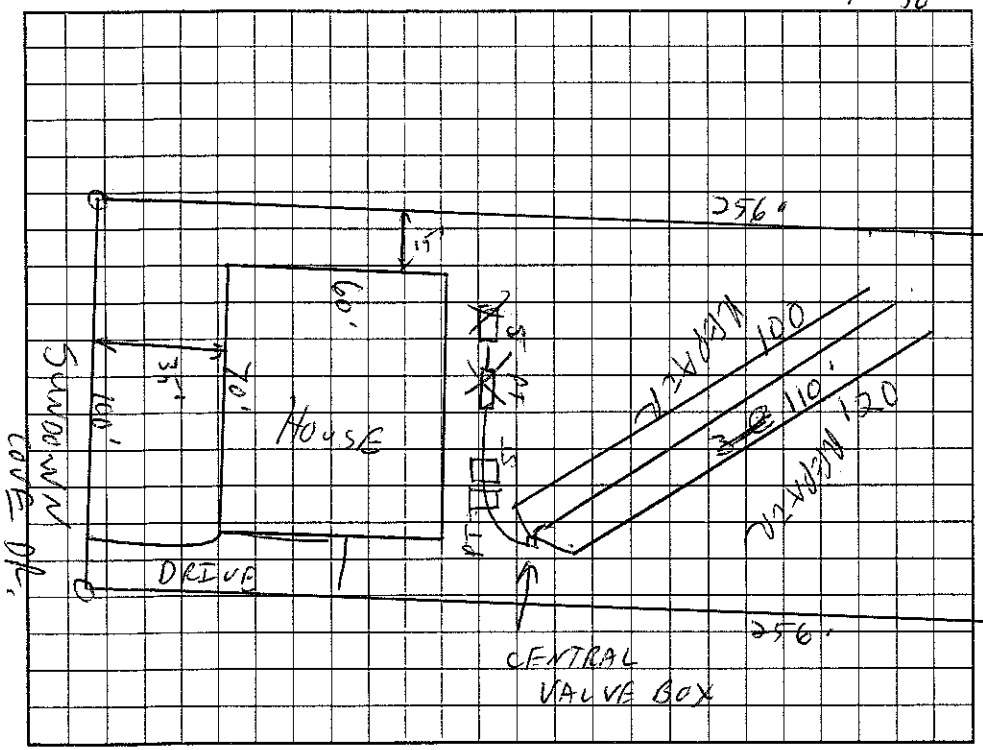

AS BUILT SKETCH

Checked tanks & lines 3/23/04

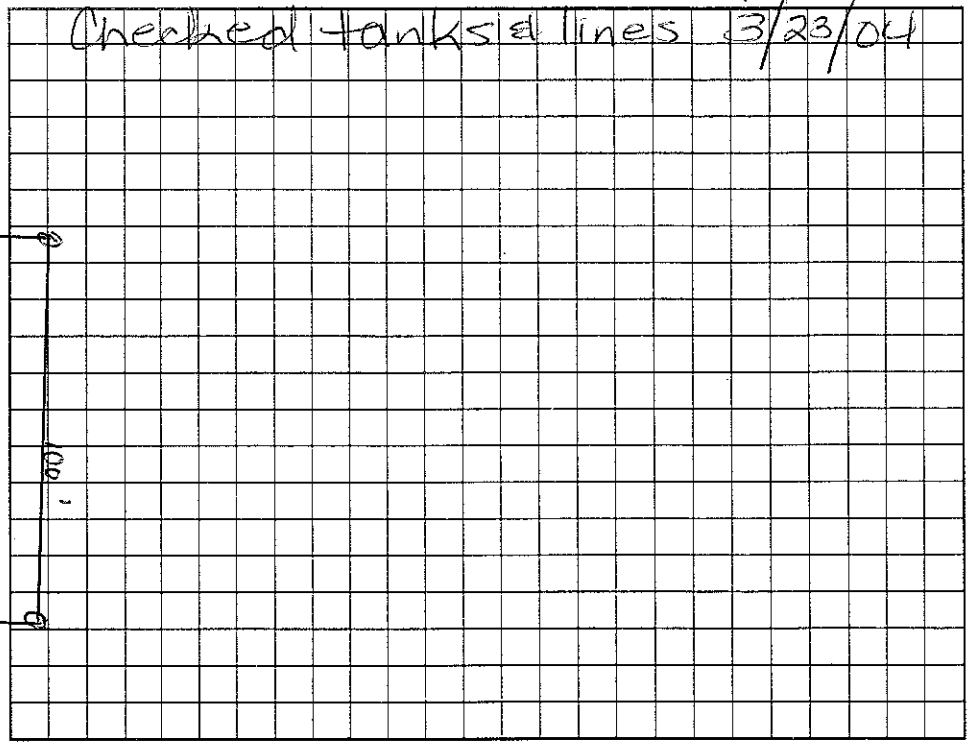

Permit can be suspended or revoked if any false information is supplied toward securing the permit/any unauthorized changes are made to the site/any unauthorized changes are made in the installation of the system. Improvement Permit with plat valid without expiration. Improvement Permit with site plan valid for sixty months. Authorization to Construct is valid for a period equal to that of Improvement Permit – not to exceed sixty months.

Signed: Robert R. Dienst date 9/20/02

Improvement Permit by: [signature] RS date 8/27/02

Authorization to Construct by: [signature] RS date 12/2/03

Installed by: R&H RS

Operation Permit by: [signature] date 4/6/04

Existing System Inspection by: date

HEALTH DEPT. COPY: WHITE OWNER COPY (FINAL): YELLOW OWNER COPY (INITIAL): PINK