IREDELL COUNTY HEALTH DEPARTMENT

STATESVILLE 704-878-5305 MOORESVILLE 704-664-5281

2.00

IMPROVEMENT PERMIT / AUTHORIZATION TO CONSTRUCT / OPERATION PERMIT / EXISTING SYSTEM INSPECTION

PERMIT# 1085600 PIN# ~~4646254611.64~~ 4646283867 DATE 10/25/02

OWNER OR CONTRACTOR DIENST ENTERPRISES / Ryan Homes NW PHONE: Business 309-0123 Home

ADDRESS 125 EASTON DRIVE MOORESVILLE NC 28117

LOCATION WILLIAMSON - TR ~~BARF~~ SUNDOWN - TR SUNDOWN COVE - TR CORONA - TL CORONA - ON LT

SUBDIVISION ESTATES @ SUNDOWN BLOCK / SECTION LOT 64 LOT AREA 25,000 SF SITE CLASS. PS DESIGN FLOW 360GPD L.T.A.R. .2 GPD/FT²

Septic Tank: 1000 Gallons; STB 312 Date 9-1-04

Pump Tank: 1000 Gallons; PT 283 Date 5-1-04

Pump Make Gould's Model Serial No.

Nitrification Field: No Fields 1 Square Feet 1440 Linear Feet 480

No Lines 4@120' Trench Width 36" Max Trench Bottom Depth 24" Gravel Depth N/A

☑ New System ☐ Repair System Type: I, II, III, IV, V, VI

System Description: PUMP INNOVATIVE

Repair System Description: SAME

Maintenance Agreement Required: ☐ Yes ☑ No

☑ House/Mod. Home No. Bedrooms 3

☐ Mobile Home No. Bathrooms 3

☐ Business No. Employees

☐ Other


☐ Slab ☑ Crawl Space ☐ Basement w/plumbing ☐ Basement wo/plumbing

Water Supply: ☐ Individual ☐ Public ☑ Community

Comments:/Conditions: 1) ONLY 3BR ~~OR~~ OR LESS CAN GO ON LOT.

Comments:/Conditions: Checked tanks & lines 3/4/05 MD Note: ~ 1 inch water (sub surface) in 1st line, notified David about it prior to inspection

INITIAL SITE SKETCH 1" = 50'

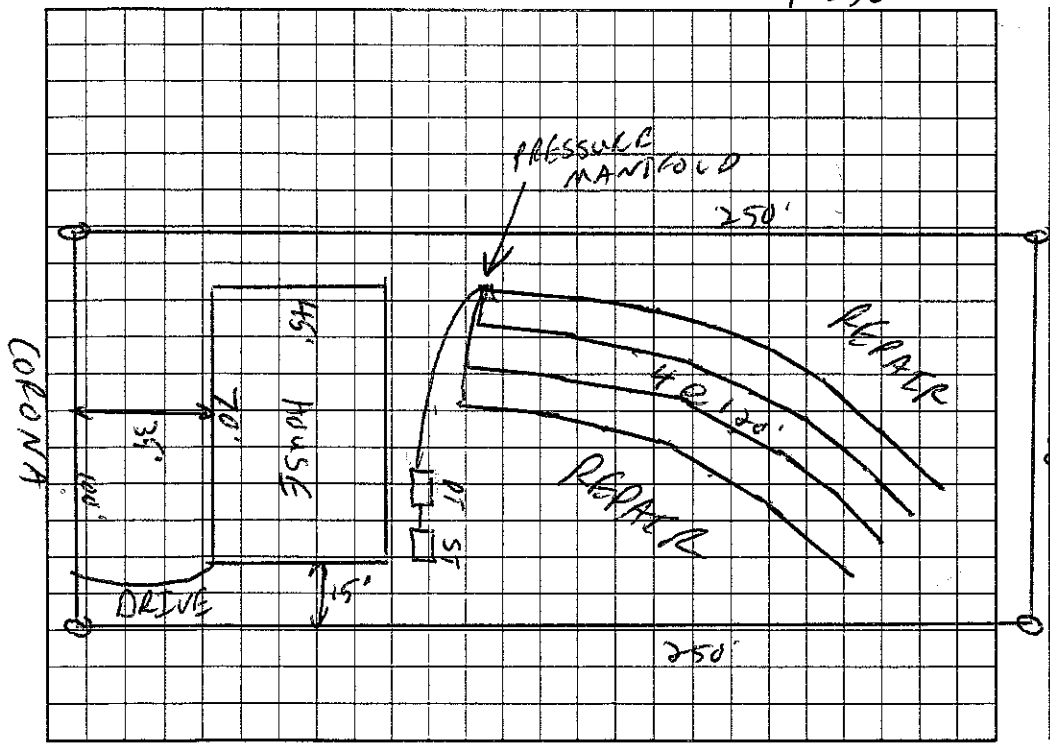

AS BUILT SKETCH



Permit can be suspended or revoked if any false information is supplied toward securing the permit/any unauthorized changes are made to the site/any unauthorized changes are made in the installation of the system. Improvement Permit with plat valid without expiration. Improvement Permit with site plan valid for sixty months. Authorization to Construct is valid for a period equal to that of Improvement Permit – not to exceed sixty months.

Signed: Robert B. Dienst date 11/27/02 Installed by: R&H

Improvement Permit by: RS date 10/25/02 Operation Permit by: Marian H. Dotson 3/16/05

Authorization to Construct by: RS date 11/30/04 Existing System Inspection by: date

HEALTH DEPT. COPY: WHITE OWNER COPY (FINAL): YELLOW OWNER COPY (INITIAL): PINK