IREDELL COUNTY HEALTH DEPARTMENT

STATESVILLE 704-878-5305 MOORESVILLE 704-664-5281

IMPROVEMENT PERMIT / AUTHORIZATION TO CONSTRUCT / OPERATION PERMIT / EXISTING SYSTEM INSPECTION

PERMIT# 106135 PIN# ~~4646-20-4611.93~~ 4646-28-4007 DATE 8/27/02

OWNER OR CONTRACTOR DIENST ENTERPRISES / RYAN HOMES PHONE: Business 309-0183 Home

ADDRESS 19315 W. CATAWBA AVE SUITE 200 CORNELIUS NC 28031

LOCATION WILLIAMSON - TR SUNDOWN - TR SUNDOWN ESTATES - TL CORONA - ON RT

SUBDIVISION ESTATES @ SUNDOWN BLOCK / SECTION 2 LOT 93 LOT AREA 25240 ± SITE CLASS. PS DESIGN FLOW 450GPD L.T.A.R. .3660/RT

Septic Tank: 1000 Gallons; STB 794 Date 2-5-04

Pump Tank: 1000 Gallons; PT 27 Date 1-18-04

Pump Make: ~~ASSOCIATED~~ Model 1/3HP Serial No.

Nitrification Field: No Fields 1 Square Feet 540 Linear Feet 270

No Lines 3@90' Trench Width 24" Max Trench Bottom Depth 36" Gravel Depth N/A

☑ New System ☐ Repair System Type: I. II. III. ⓘ V. VI

System Description: LP PANEL

Repair System Description: SAME

Maintenance Agreement Required: ☑ Yes ☐ No

☑ House/Mod. Home No. Bedrooms 4

☐ Mobile Home No. Bathrooms 4

☐ Business No. Employees

☐ Other


☐ Slab ☑ Crawl Space ☐ Basement w/plumbing ☐ Basement wo/plumbing

Water Supply: ☐ Individual ☐ Public ☑ Community


Comments/Conditions: 1) INLINE PUMP FILTER TO BE INSTALLED

Comments/Conditions: 3/16" hole drilled

INITIAL SITE SKETCH 1"=50'

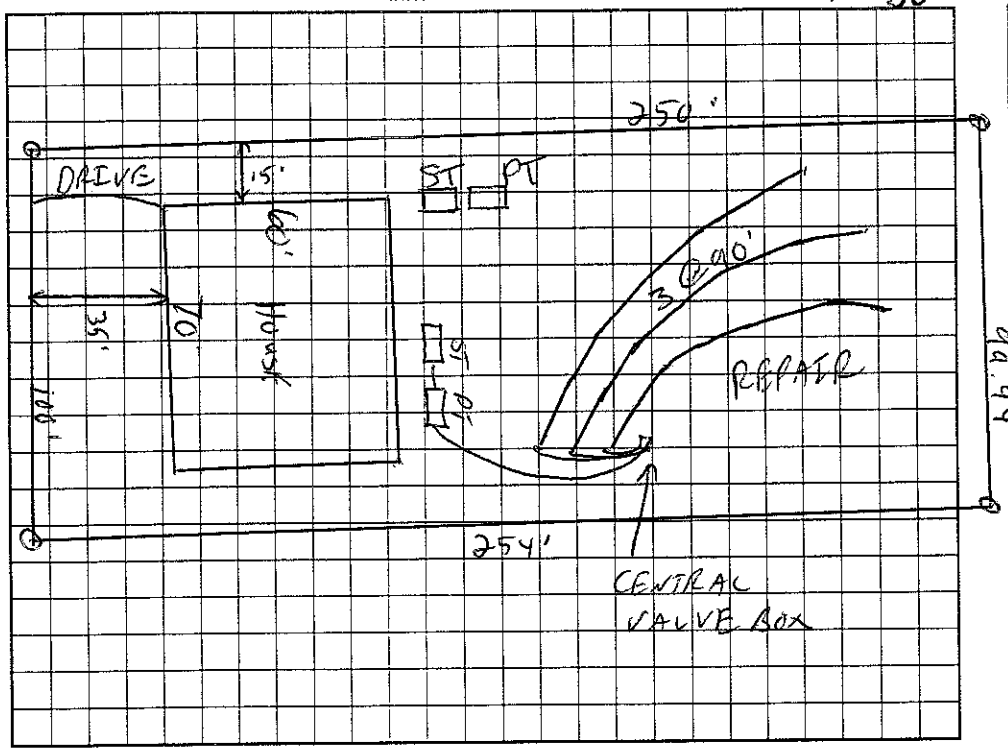

AS BUILT SKETCH

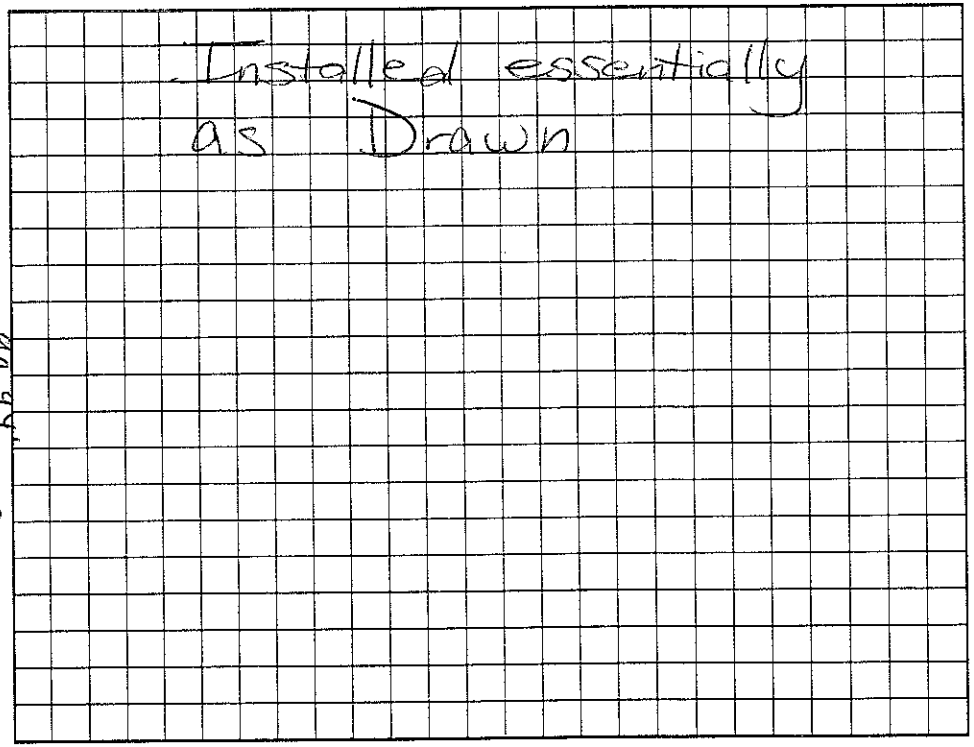

Permit can be suspended or revoked if any false information is supplied toward securing the permit/any unauthorized changes are made to the site/any unauthorized changes are made in the installation of the system. Improvement Permit with plat valid without expiration. Improvement Permit with site plan valid for sixty months. Authorization to Construct is valid for a period equal to that of Improvement Permit not to exceed sixty months.

Signed: Robert R. Dienst date 9/20/02 Installed by: R&T, Inc

Improvement Permit by: C. [illegible] RS date 8/27/02 Operation Permit by: [illegible] LS date 4/5/04

Authorization to Construct by: C. [illegible] RS date 1/13/04 Existing System Inspection by: date

HEALTH DEPT. COPY: WHITE OWNER COPY (FINAL): YELLOW OWNER COPY (INITIAL): PINK