IREDELL COUNTY HEALTH DEPARTMENT

STATESVILLE 704-878-5305 MOORESVILLE 704-664-5281

IMPROVEMENT PERMIT / AUTHORIZATION TO CONSTRUCT / OPERATION PERMIT / EXISTING SYSTEM INSPECTION

PERMIT# 108601 PIN# ~~4646-28-4611.63~~ 4646-28-4867 DATE 10/25/02

OWNER OR CONTRACTOR DIENST ESTATES INC / Ryan Homes PHONE: Business 892-8425 Home

ADDRESS 14315 W. CATAWBA CORNELIUS NC 28031

LOCATION WILLIAMSON - TR SUNDOWN - TR SUNDOWN COVE - TR CORONA - TL CORONA - ON LT

SUBDIVISION ESTATES @ SUNDOWN BLOCK / SECTION 2 LOT 63 LOT AREA 25000 ft² SITE CLASS. PS DESIGN FLOW 450 GPD L.T.A.R. .2568 / FT²

Septic Tank: 1000 Gallons; STB 312 Date 11/21/04

Pump Tank: 1000 Gallons; PT 27 Date 11/27/04

Pump Make: Zoeller Model WE03 Serial No.

Nitrification Field: No Fields 1 Square Feet 640 Linear Feet 320

No Lines 4 @ 80' Trench Width 24" Max Trench Bottom Depth 36" Gravel Depth

☑ New System ☐ Repair System Type: I. II. III. (IV) V. VI

System Description: LP PANEL

Repair System Description: SAME

Maintenance Agreement Required: ☑ Yes ☐ No

☑ House/Mod. Home No. Bedrooms 4

☐ Mobile Home No. Bathrooms 4

☐ Business No. Employees

☐ Other


☐ Slab ☑ Crawl Space ☐ Basement w/plumbing ☐ Basement wo/plumbing

Water Supply: ☐ Individual ☐ Public ☑ Community

Comments/Conditions:

Comments/Conditions: 12/6/05 Checked pressure elect & alarm 12/29/05 Tanks & lines checked by GM (Contract attached)

INITIAL SITE SKETCH 1" = 50'

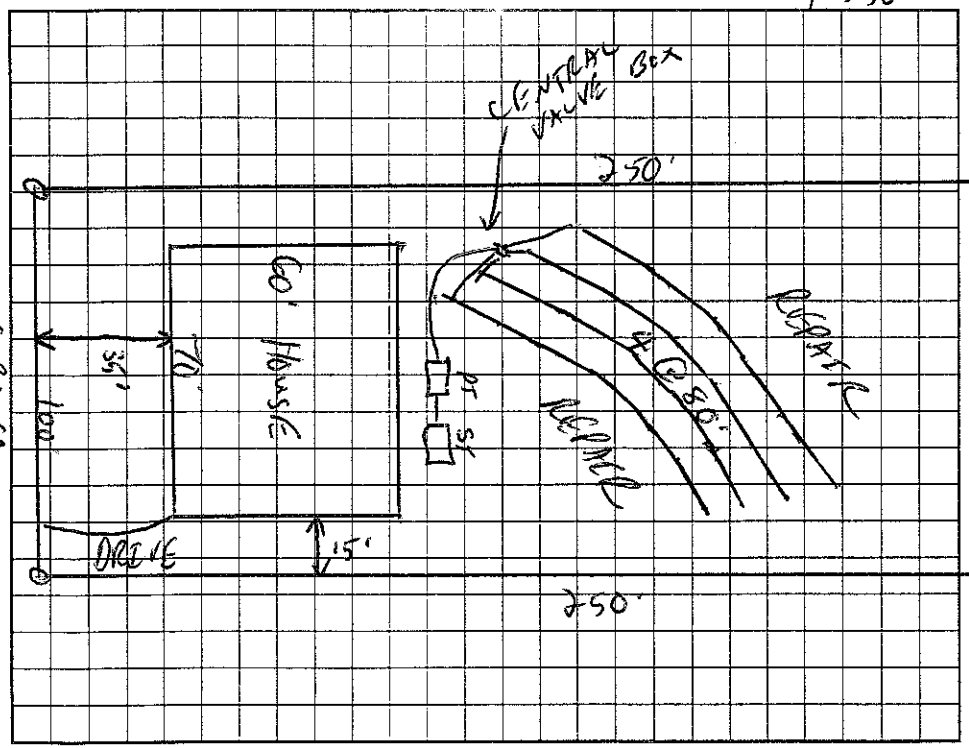

AS BUILT SKETCH

Permit can be suspended or revoked if any false information is supplied toward securing the permit/any unauthorized changes are made to the site/any unauthorized changes are made in the installation of the system. Improvement Permit with plat valid without expiration. Improvement Permit with site plan valid for sixty months. Authorization to Construct is valid for a period equal to that of Improvement Permit – not to exceed sixty months.

Signed: Robert B. Dienst date 11/27/02

Improvement Permit by: RS date 10/25/02

Authorization to Construct by: RS date 10/20/04

Installed by: R+H

Operation Permit by: RS date 11/26/05

Existing System Inspection by: date

HEALTH DEPT. COPY: WHITE OWNER COPY (FINAL): YELLOW OWNER COPY (INITIAL): PINK