3:00

IREDELL COUNTY HEALTH DEPARTMENT

STATESVILLE 704-878-5305 MOORESVILLE 704-664-5281

IMPROVEMENT PERMIT / AUTHORIZATION TO CONSTRUCT / OPERATION PERMIT / EXISTING SYSTEM INSPECTION

PERMIT# 106137 PIN# ~~4646 20 46 11 94~~ 4646-28-5006 DATE 8/27/02

OWNER OR CONTRACTOR DIENST ENTERPRESES PHONE: Business 309-0103 Home

ADDRESS 19315 W. CATAWBA AVE SUITE 200 CORNELIUS NC 28031

LOCATION WILLIAMSON - TR SUNDOWN - TR SUNDOWN COVE - TL CORONA - ON RT

SUBDIVISION ESTATES@SUNDOWN BLOCK / SECTION 2 LOT 94 LOT AREA 25578 ft² SITE CLASS OS DESIGN FLOW 480GPD L.T.A.R. .3600/FT²

Septic Tank: 1000 Gallons; STB ~~794~~ Date 11-2-03

Pump Tank: 1000 Gallons; PT 27 Date 10-30-03

Pump Make: _____ Model _____ Serial No. _____

Nitrification Field: No Fields 1 Square Feet ~~560~~ 560 Linear Feet 280

No Lines 4 @ 70' Trench Width 24" Max Trench Bottom Depth 36" Gravel Depth N/A

☑ New System ☐ Repair System Type: I, II, III, IV, V, VI

System Description: LP PANEL

Repair System Description: SAME

Maintenance Agreement Required: ☑ Yes ☐ No

☑ House/Mod. Home No. Bedrooms 4

☐ Mobile Home No. Bathrooms 4

☐ Business No. Employees

☐ Other

☐ Slab ☑ Crawl Space ☐ Basement w/plumbing ☐ Basement wo/plumbing

Water Supply: ☐ Individual ☐ Public ☑ Community

Comments/Conditions: 1) INLINE PUMP FILTER TO BE INSTALLED


DRIVE WILL BE on opposite side

Comments:/Conditions: Checked Tanks & lines 12/16/03

"Used tar rope Seal"

Pressure, elect & alarm 12/18/03

INITIAL SITE SKETCH 1" = 50'

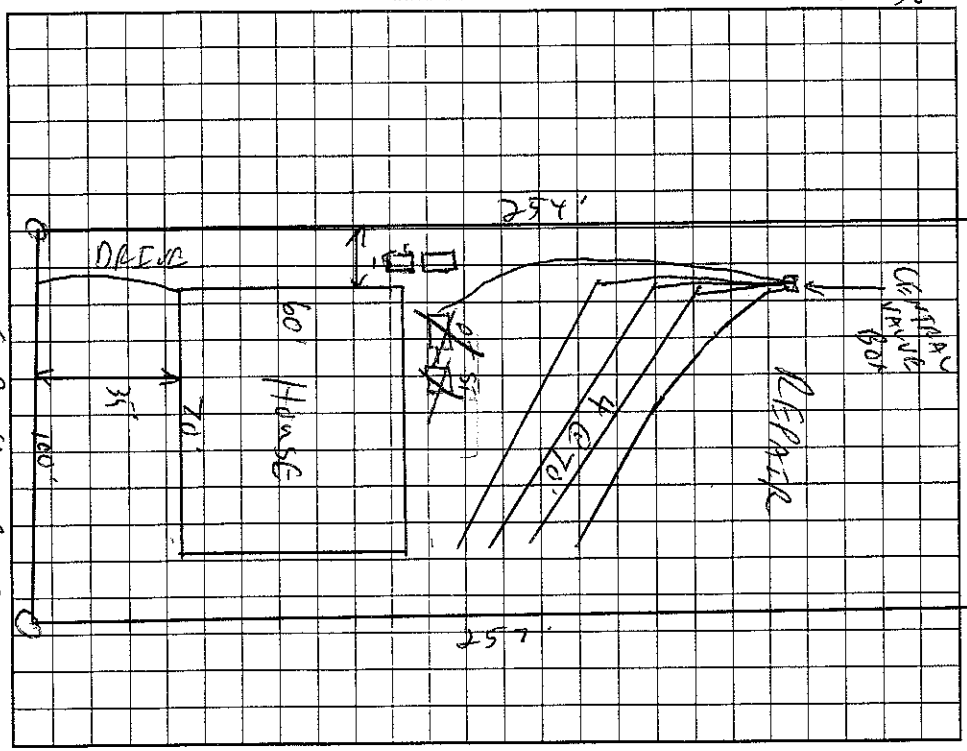

AS BUILT SKETCH

Installed as drawn

Permit can be suspended or revoked if any false information is supplied toward securing the permit/any unauthorized changes are made to the site/any unauthorized changes are made in the installation of the system. Improvement Permit with plat valid with no expiration. Improvement Permit with site plan valid for sixty months. Authorization to Construct is valid for a period equal to that of Improvement Permit – not to exceed sixty months.

Signed: Robert B. Dienst date 9/20/02

Improvement Permit by: _____ RS date 8/27/02

Authorization to Construct by: _____ RS date 9/9/03

Installed by: R & H

Operation Permit by: Marvin H. Dotson RS date 12/18/03

Existing System Inspection by: _____ date _____

HEALTH DEPT. COPY: WHITE OWNER COPY (FINAL): YELLOW OWNER COPY (INITIAL): PINK